City of Prince George
HISTORY SHEET

SHEET NUMBER 5812 **Roll Number** 008021562

Legal: LOT'S 3 BLOCK — D.L. 754 PLAN 25106

Address: 8263 ST JOHN CRESCENT

Sanitary Connection: # SIZE 4"Ø MATERIAL P.V.C. (WHITE) INV. 2114.44 CONNECTED

Water Connection # SIZE 3/4"Ø MATERIAL COPPER METER CONNECTED

Storm Connection: # SIZE 4" Ø MATERIAL P.V.C. INV. 2114.44 CONNECTED

Cash Receipt No's: WATER SANITARY STORM

CURB FROM PROPERTY LINE 16'-0" PAVEMENT WIDTH

B.C. HYDRO UNDERGROUND CONNECTION U/G

B.C. TELEPHONE UNDERGROUND CONNECTION U/G

INLAND GAS

Information Sheets: THE INFORMATION CONTAINED HEREIN IS FOR INTERNAL USE ONLY. NOT TO BE RELIED UPON UNLESS CONFIRMED BY SITE INSPECTION AND/OR INVESTIGATION.

Comments: ELEVATION 2096.36'

HYD. ARROW INT. ST. PATRICK & ST. LAWRENCE

LEVEL BOOK # 46
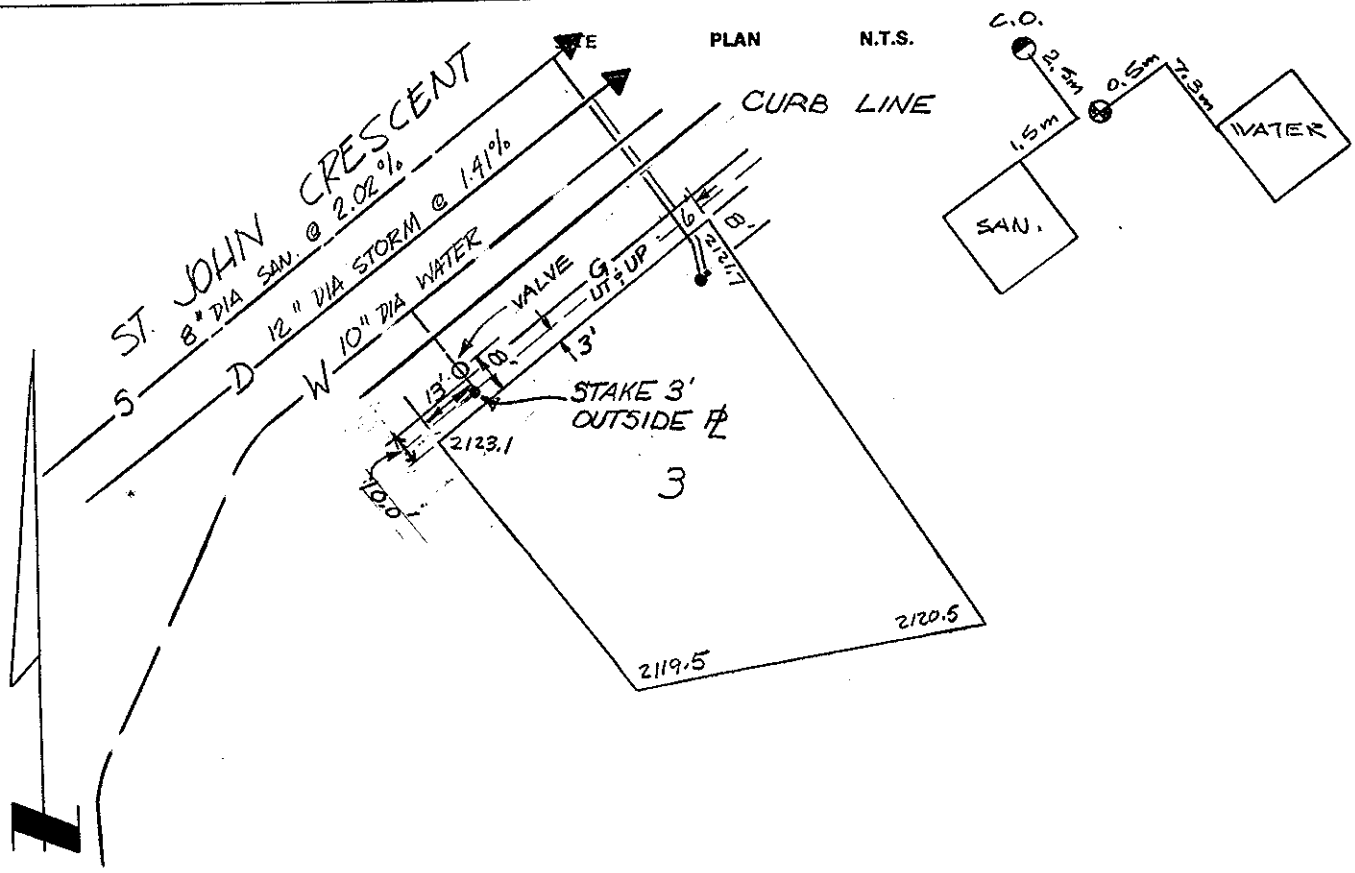
SITE PLAN N.T.S.