City of Prince George
HISTORY SHEET

2021 HM

SHEET NUMBER **Roll Number** 021

Legal: LOT'S 23, 24 BLOCK 84 D.L. 937 PLAN 752

Address: 290 JOHNSON STREET

Sanitary Connection: # 2758 SIZE 4" MATERIAL A.C. INV. CONNECTED

Water Connection # 1221 SIZE 3/4" MATERIAL METER CONNECTED

Storm Connection: # SIZE MATERIAL INV. CONNECTED

Cash Receipt No's: WATER SANITARY 107 STORM

CURB FROM PROPERTY LINE PAVEMENT WIDTH

B.C. HYDRO UNDERGROUND CONNECTION

B.C. TELEPHONE UNDERGROUND CONNECTION

INLAND GAS

Information Sheets:

Comments:

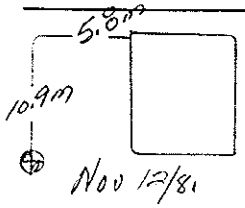
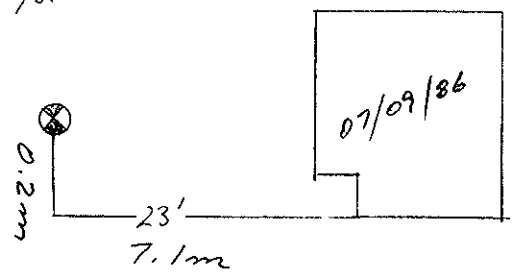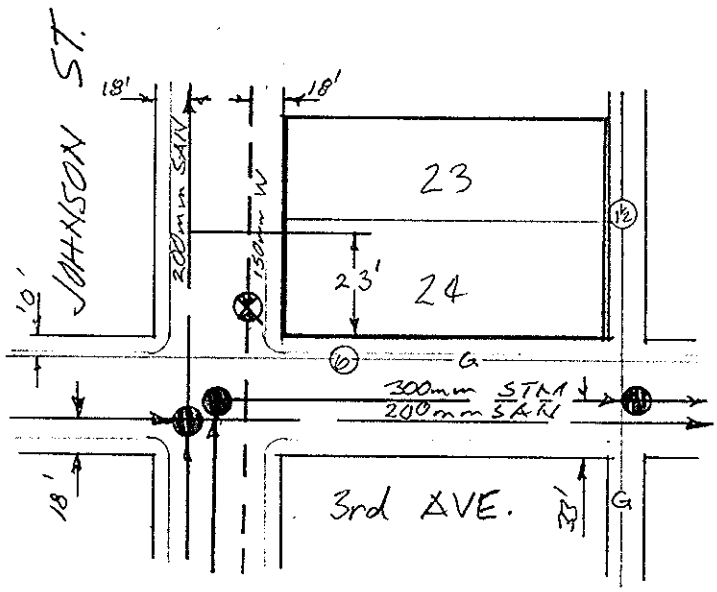
SITE PLAN N.T.S.