City of Prince George
HISTORY SHEET

008036748

SHEET NUMBER | **Roll Number** 772

Legal: LOT'S 21-22 BLOCK 82 D.L. 937 PLAN 752

Address: 274 KELLY ST.

Sanitary Connection: # 3184 SIZE 100 mm MATERIAL A.C INV. 597.361 CONNECTED

Water Connection # 3412 SIZE 20 mm MATERIAL CU. METER CONNECTED

Storm Connection: # SIZE MATERIAL INV. CONNECTED

Cash Receipt No's: WATER SANITARY STORM

CURB FROM PROPERTY LINE 4.877 m PAVEMENT WIDTH 10.363 m

B.C. HYDRO O/H UNDERGROUND CONNECTION

B.C. TELEPHONE O/H UNDERGROUND CONNECTION

INLAND GAS 1.524 m FROM PL IN LANE.

Information Sheets:

Comments: WITH THAW WIRE.

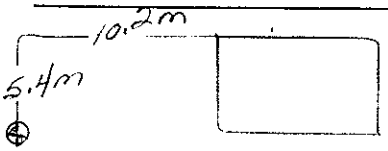
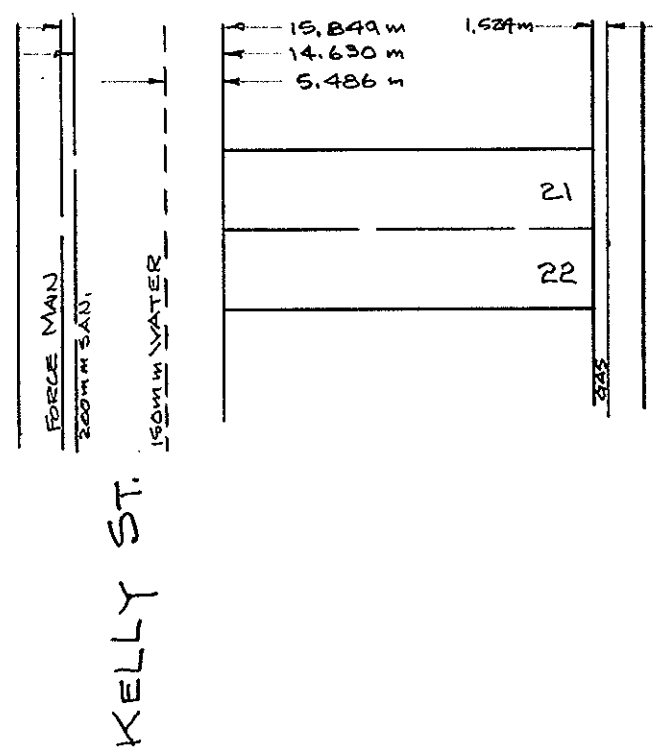
SITE PLAN N.T.S.