# City of Prince George
## HISTORY SHEET

008032795 HM

SHEET NUMBER **Roll Number** 931

**Legal:** LOT'S 17, 18 BLOCK 84 D.L. 937 PLAN 752

**Address:** 242 JOHNSON STREET

**Sanitary Connection:** # 3768 SIZE MATERIAL INV. CONNECTED

**Water Connection** # 1218 SIZE 3/4" MATERIAL COPPER METER CONNECTED

**Storm Connection:** # SIZE MATERIAL INV. CONNECTED

**Cash Receipt No's:** WATER SANITARY STORM

CURB FROM PROPERTY LINE PAVEMENT WIDTH

B.C. HYDRO UNDERGROUND CONNECTION

B.C. TELEPHONE UNDERGROUND CONNECTION

INLAND GAS

**Information Sheets:**

**Comments:**
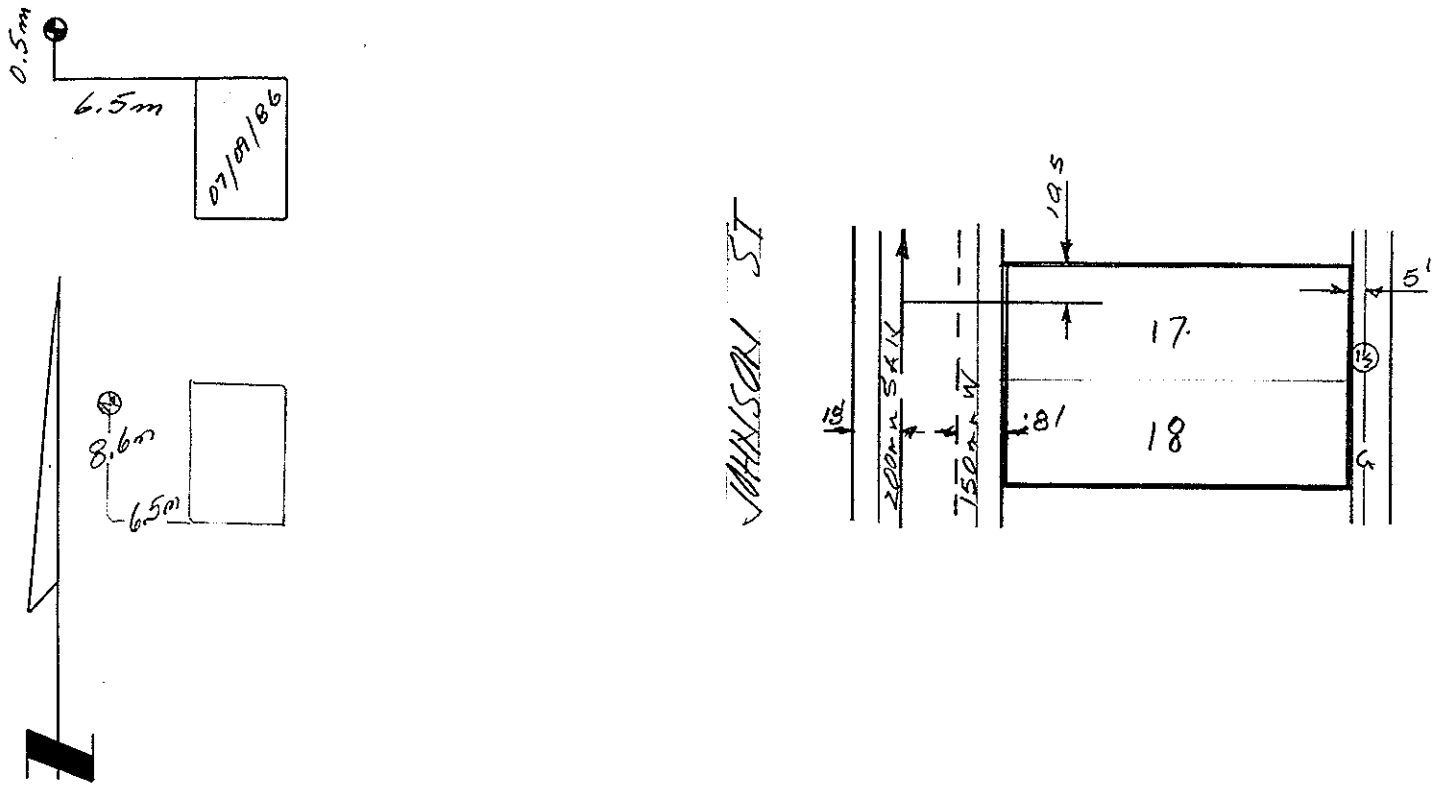
SITE PLAN N.T.S.