City of Prince George
HISTORY SHEET

D
208042.446

SHEET NUMBER 1855 **Roll Number**

Legal: LOT'S 61 BLOCK — D.L. 905 PLAN 24848

Address: 4119 PRUDENTE CRES.

Sanitary Connection: # 12253 SIZE 100mm ϕ MATERIAL AC INV. 38.99 CONNECTED

Water Connection # 12253 SIZE 20mm ϕ MATERIAL PVC METER CONNECTED

Storm Connection: # 1174 SIZE 100mm ϕ MATERIAL PVC INV. 39.00 CONNECTED

Cash Receipt No's: WATER SANITARY STORM

CURB FROM PROPERTY LINE 5m PAVEMENT WIDTH 10m

B.C. HYDRO UGP-234 UNDERGROUND CONNECTION

B.C. TELEPHONE UT-335 UNDERGROUND CONNECTION

INLAND GAS G-446 -32mm GAS MAIN

Information Sheets:
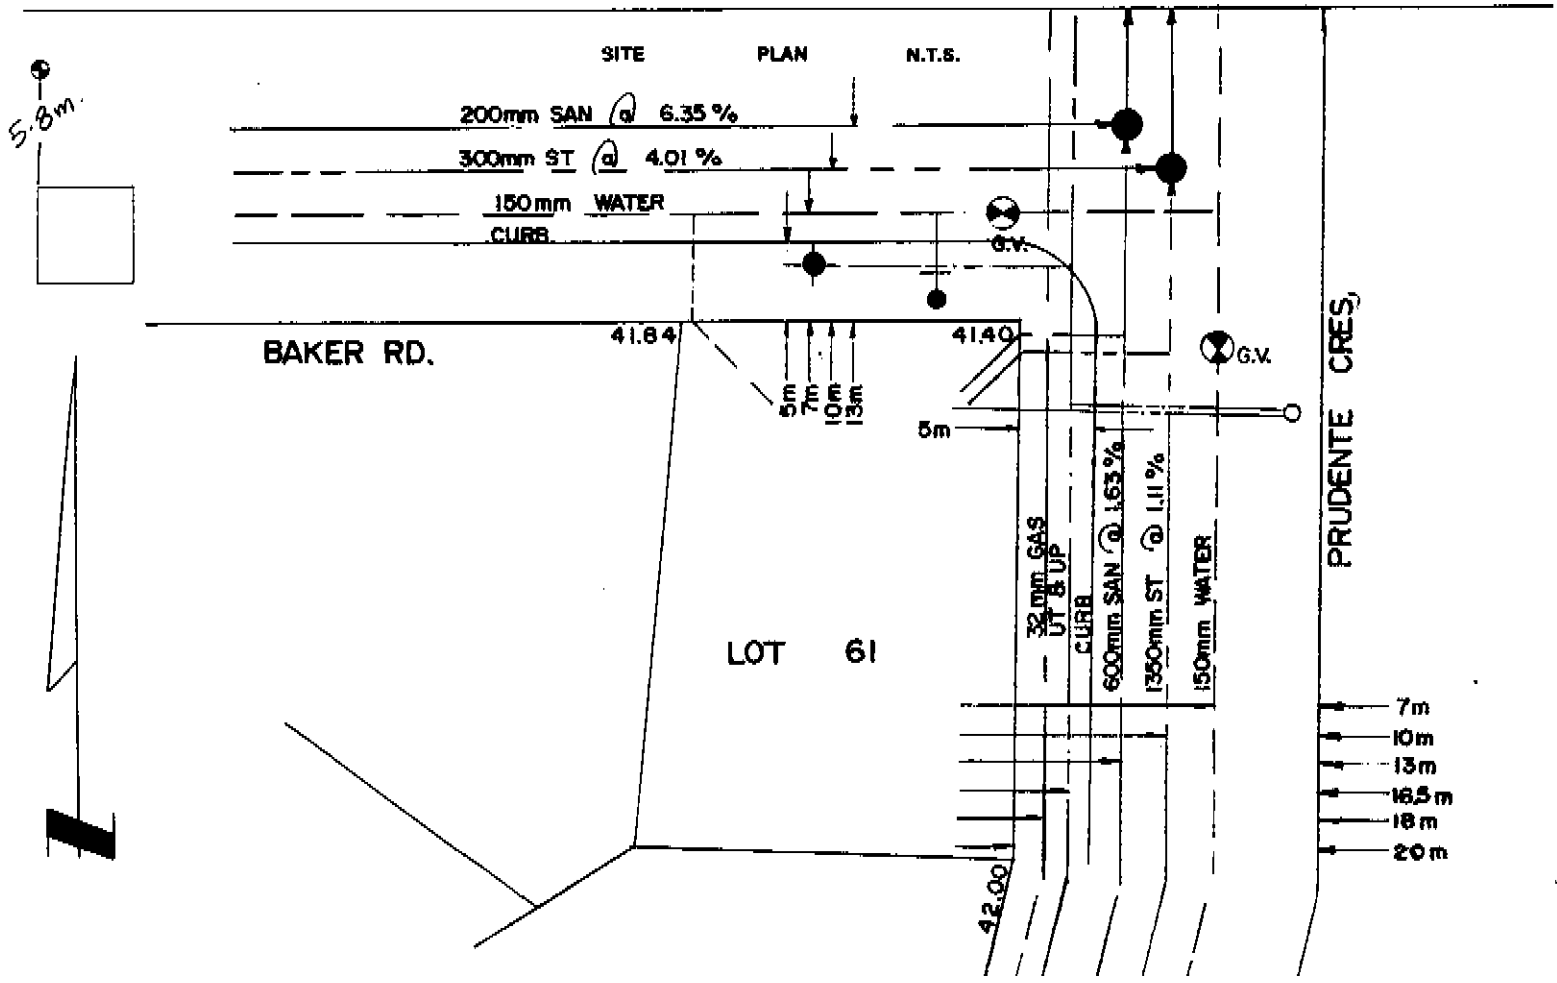
Comments: B.M. S.I.P. N.W. COR. DAVIS & PRUDENTE ELEV. 647.586
LEV. BK. 366