City of Prince George
HISTORY SHEET

0080426 91

SHEET NUMBER 1832 Roll Number

Legal: LOT'S 19 BLOCK — D.L. 905 PLAN 24848

Address: 4151 BAKER RD

Sanitary Connection: # 12219 SIZE 100 mm ϕ MATERIAL AC INV. 42.53 CONNECTED

Water Connection # 12219 SIZE 20 mm ϕ MATERIAL PVC METER CONNECTED

Storm Connection: # 1140 SIZE 100 mm ϕ MATERIAL PVC INV. 42.61 CONNECTED

Cash Receipt No's: WATER SANITARY STORM

CURB FROM PROPERTY LINE 5m PAVEMENT WIDTH 10m

B.C. HYDRO UGP - 234 UNDERGROUND CONNECTION

B.C. TELEPHONE UT - 335 UNDERGROUND CONNECTION

INLAND GAS G-446 - 32mm GAS MAIN

Information Sheets:

Comments: B.M. S.I.P. N.W. COR. DAVIS & BAKER ELEV. 648.450
LEV. BK. 366
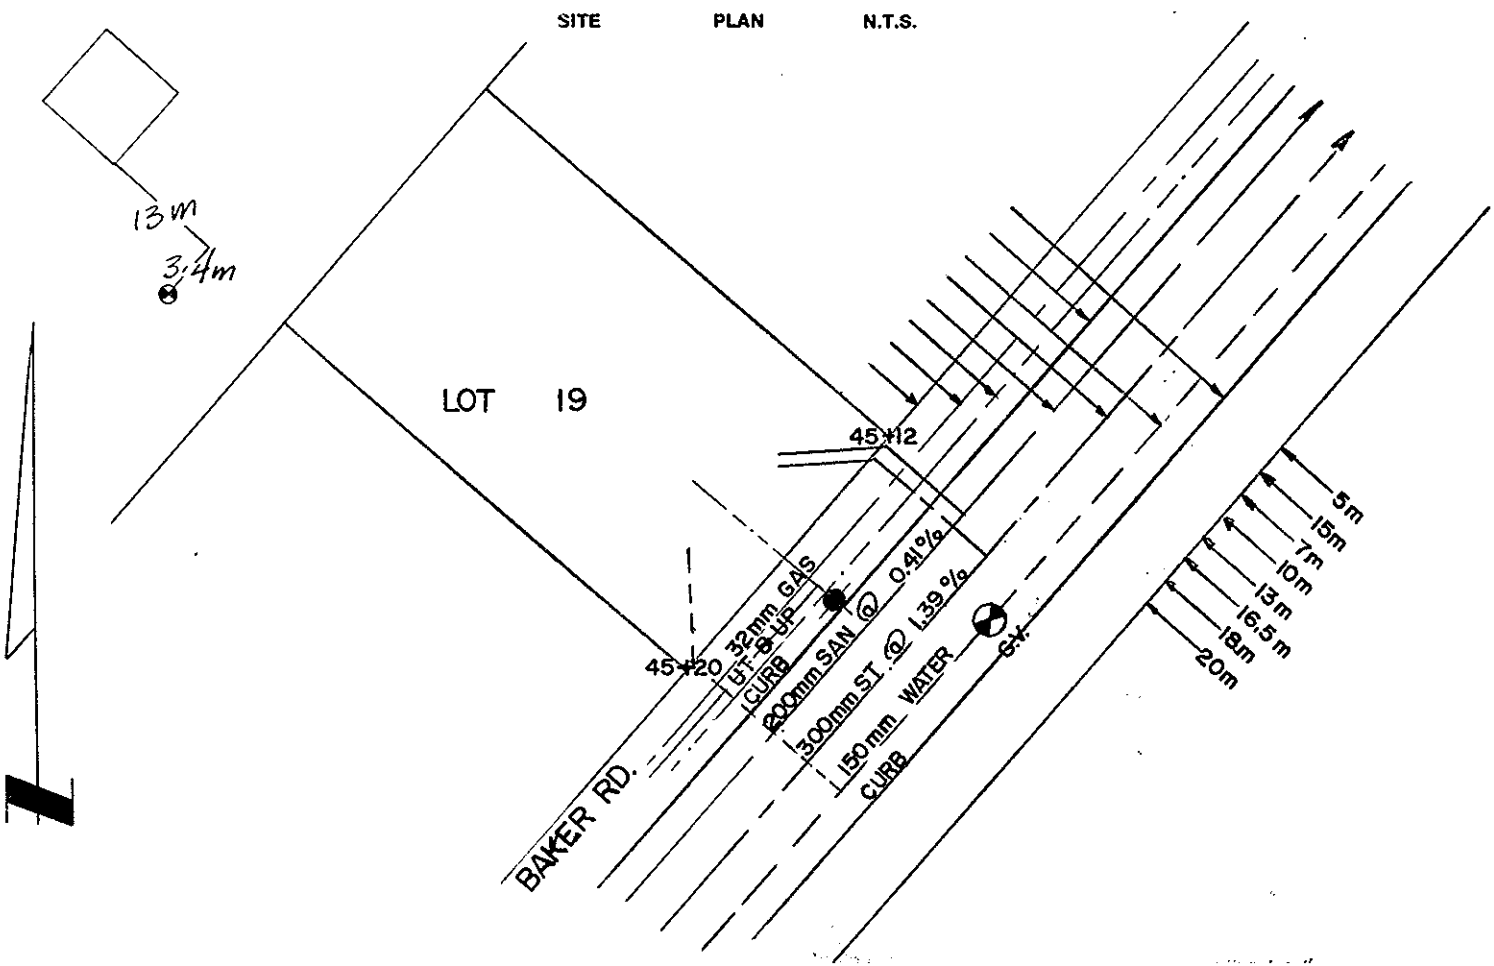
SITE PLAN N.T.S.