City of Prince George
HISTORY SHEET

SHEET NUMBER № 2585 **Roll Number** 008087105

Legal: LOT'S 5 BLOCK D.L. 751 PLAN 24776

Address: PENN RD.

Sanitary Connection: # 15207 SIZE [illegible] MATERIAL INV. CONNECTED

Water Connection # 15207 SIZE 150mm MATERIAL METER CONNECTED

Storm Connection: # 1406 SIZE 300mm MATERIAL INV. CONNECTED

Cash Receipt No's: WATER SANITARY [illegible] STORM

CURB FROM PROPERTY LINE PAVEMENT WIDTH

B.C. HYDRO UNDERGROUND CONNECTION

B.C. TELEPHONE UNDERGROUND CONNECTION

INLAND GAS

Information Sheets:

Comments:

The information contained herein is for internal use only. Not to be relied upon unless confirmed by site inspection and/or investigation.
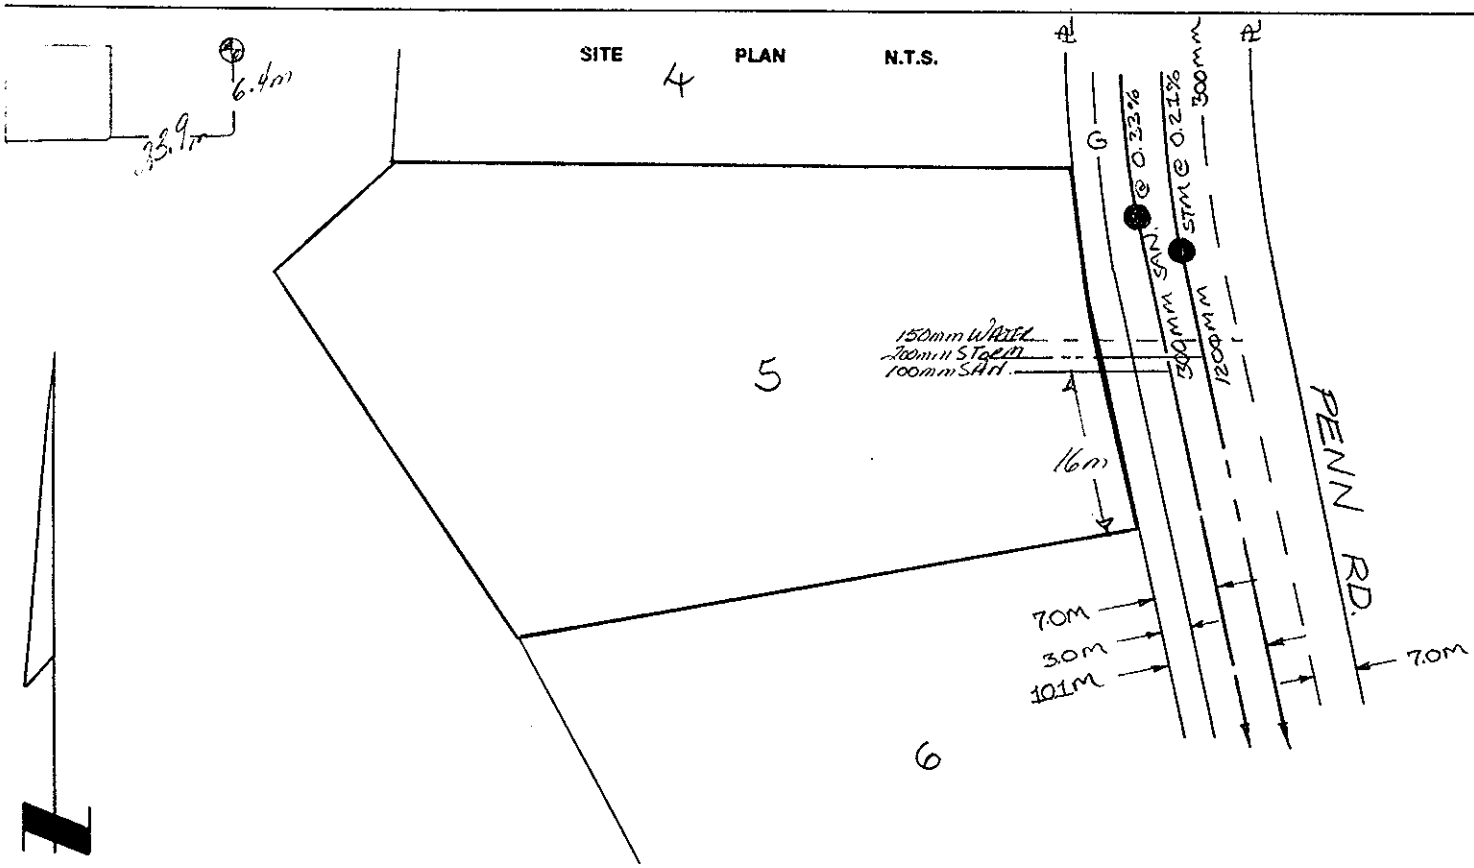
SITE PLAN N.T.S.