City of Prince George
HISTORY SHEET

00813195
00813196

SHEET NUMBER | **Roll Number**

Legal: LOT'S 23-24 & A BLOCK 203 D.L. 343 PLAN 1268

Address: 1688 11th AVE.

Sanitary Connection: # 157 SIZE MATERIAL INV. 1884.91 CONNECTED YES

Water Connection # 2509 SIZE 3/4" MATERIAL CU. METER CONNECTED YES

Storm Connection: # SIZE MATERIAL INV. CONNECTED

Cash Receipt No's: WATER SANITARY STORM

CURB FROM PROPERTY LINE 16' PAVEMENT WIDTH 34'

B.C. HYDRO O.H. UNDERGROUND CONNECTION

B.C. TELEPHONE O.H. UNDERGROUND CONNECTION

INLAND GAS IN LANE ϕ 3" MAIN

THE INFORMATION CONTAINED HEREIN IS FOR INTERNAL USE ONLY. NOT TO BE RELIED UPON UNLESS CONFIRMED BY SITE INSPECTION AND/OR INVESTIGATION.

Information Sheets:

Comments: BENCH MARK #53-75 ELEV. 1894.26
H.S. N.E. CORNER 11th AND PRINCE RUPERT
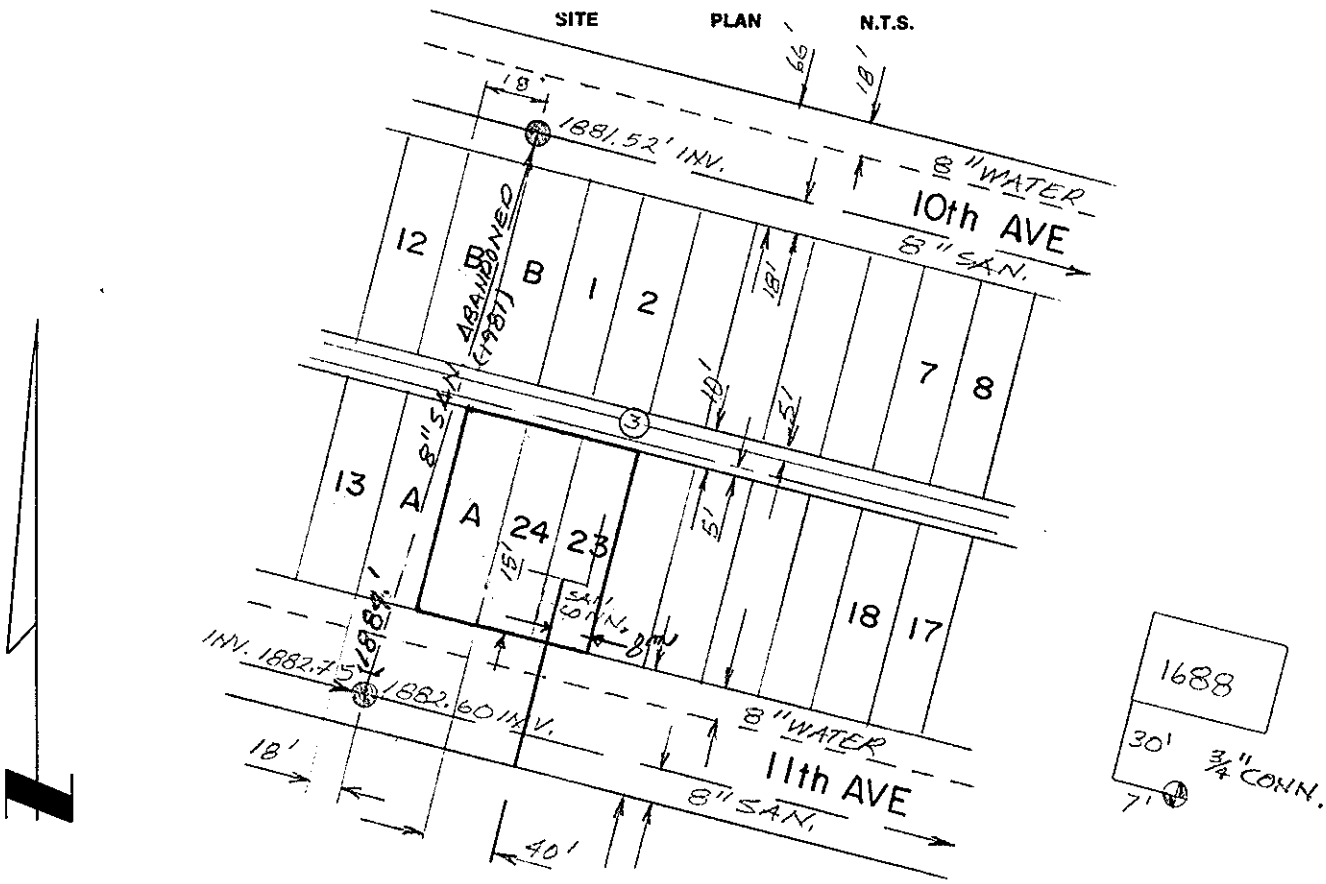
SITE PLAN N.T.S.