City of Prince George
HISTORY SHEET

GO8152811

SHEET NUMBER

Roll Number 845

Legal: LOT'S 11, 12 BLOCK 88 D.L. 9,37 PLAN 752

Address: 207 EWERT STREET

Sanitary Connection: # 504 SIZE MATERIAL INV. CONNECTED

Water Connection # 1244 SIZE ½" MATERIAL METER CONNECTED

Storm Connection: # SIZE MATERIAL INV. CONNECTED

Cash Receipt No's: WATER SANITARY STORM

CURB FROM PROPERTY LINE PAVEMENT WIDTH

B.C. HYDRO UNDERGROUND CONNECTION

B.C. TELEPHONE UNDERGROUND CONNECTION

INLAND GAS

Information Sheets:

Comments:

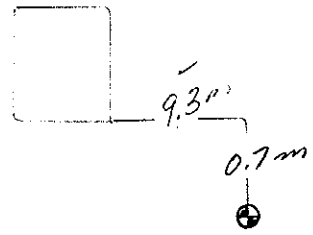
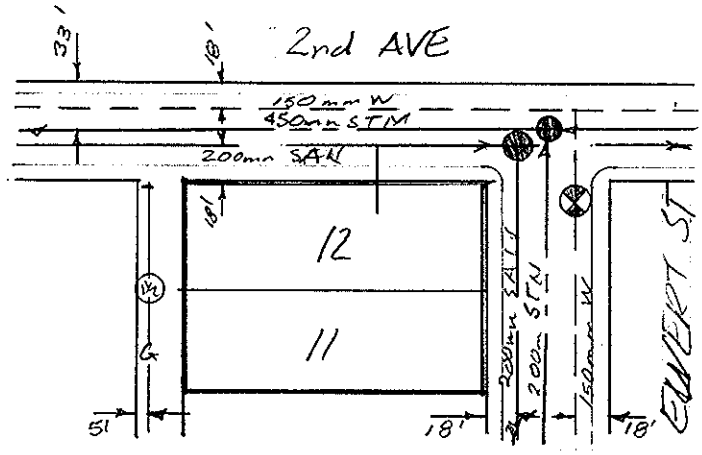
SITE PLAN N.T.S.