City of Prince George
HISTORY SHEET

SHEET NUMBER № 3333 166 – 169

Roll Number

Legal: LOT'S 173 - 176 BLOCK D.L. 2507 PLAN 15185

Address: 3820 – 15th. AVE.

Sanitary Connection: # 4992 4993 4994 4995 SIZE 4" MATERIAL ACS. INV. CONNECTED

Water Connection # 4285 4287 4286 4288 SIZE 1 1/2 MATERIAL Cu. METER CONNECTED

Storm Connection: # SIZE MATERIAL INV. CONNECTED

Cash Receipt No's: WATER SANITARY STORM

CURB FROM PROPERTY LINE 16' PAVEMENT WIDTH

B.C. HYDRO UNDERGROUND CONNECTION U/G

B.C. TELEPHONE UNDERGROUND CONNECTION U/G

INLAND GAS 12' OFFSET

Information Sheets:

Comments: 166 – 169 COMBINED
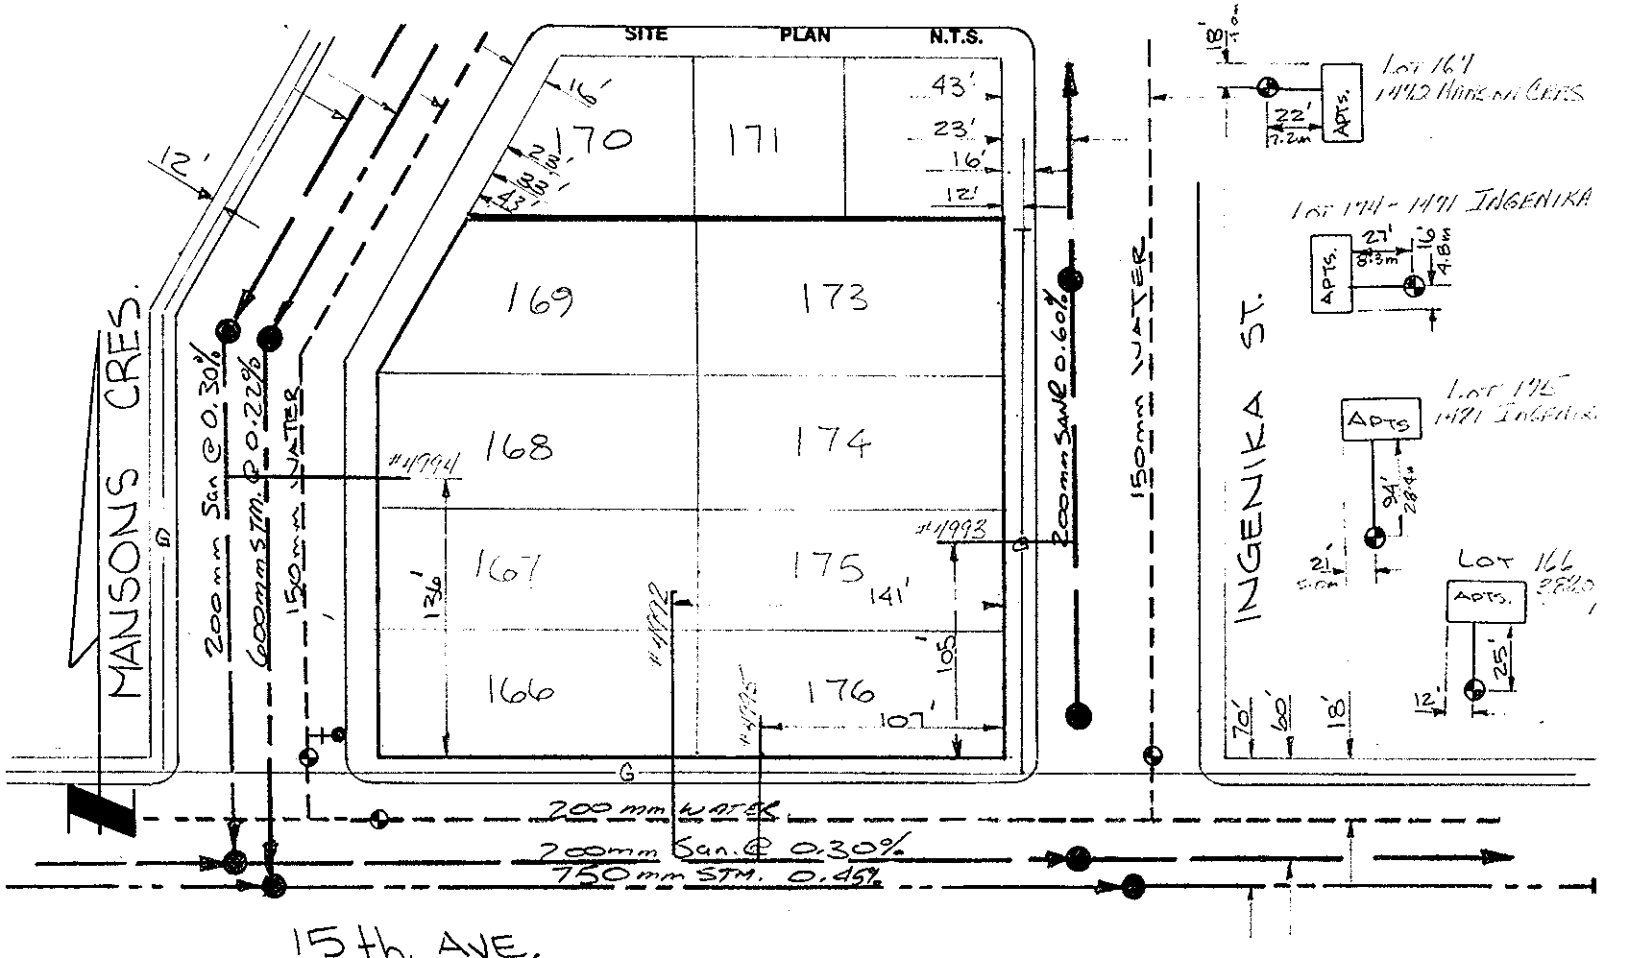
173 - 176 COMBINED