023

City of Prince George
HISTORY SHEET

SHEET NUMBER

Roll Number

Legal: LOT'S 4-7 + 13-21 BLOCK 160 D.L. 936 PLAN 696

Address: 1630-1636 CENTRAL STREET EAST

Sanitary Connection: # 4241 3955 4972 SIZE 100mm MATERIAL A.C.S. INV. CONNECTED

Water Connection # 4275 4026 SIZE 25mm 40mm MATERIAL Cu METER CONNECTED

Storm Connection: # 132 SIZE 150mm MATERIAL INV. CONNECTED

Cash Receipt No's: WATER SANITARY STORM 2297

CURB FROM PROPERTY LINE 5m PAVEMENT WIDTH

B.C. HYDRO UNDERGROUND CONNECTION

B.C. TELEPHONE UNDERGROUND CONNECTION

INLAND GAS

THE INFORMATION CONTAINED HEREIN IS FOR INTERNAL USE ONLY NOT TO BE RELIED UPON UNLESS CONFIRMED BY SITE INSPECTION AND/OR INVESTIGATION.

Information Sheets: R.P. #69 ENG [illegible] #2221
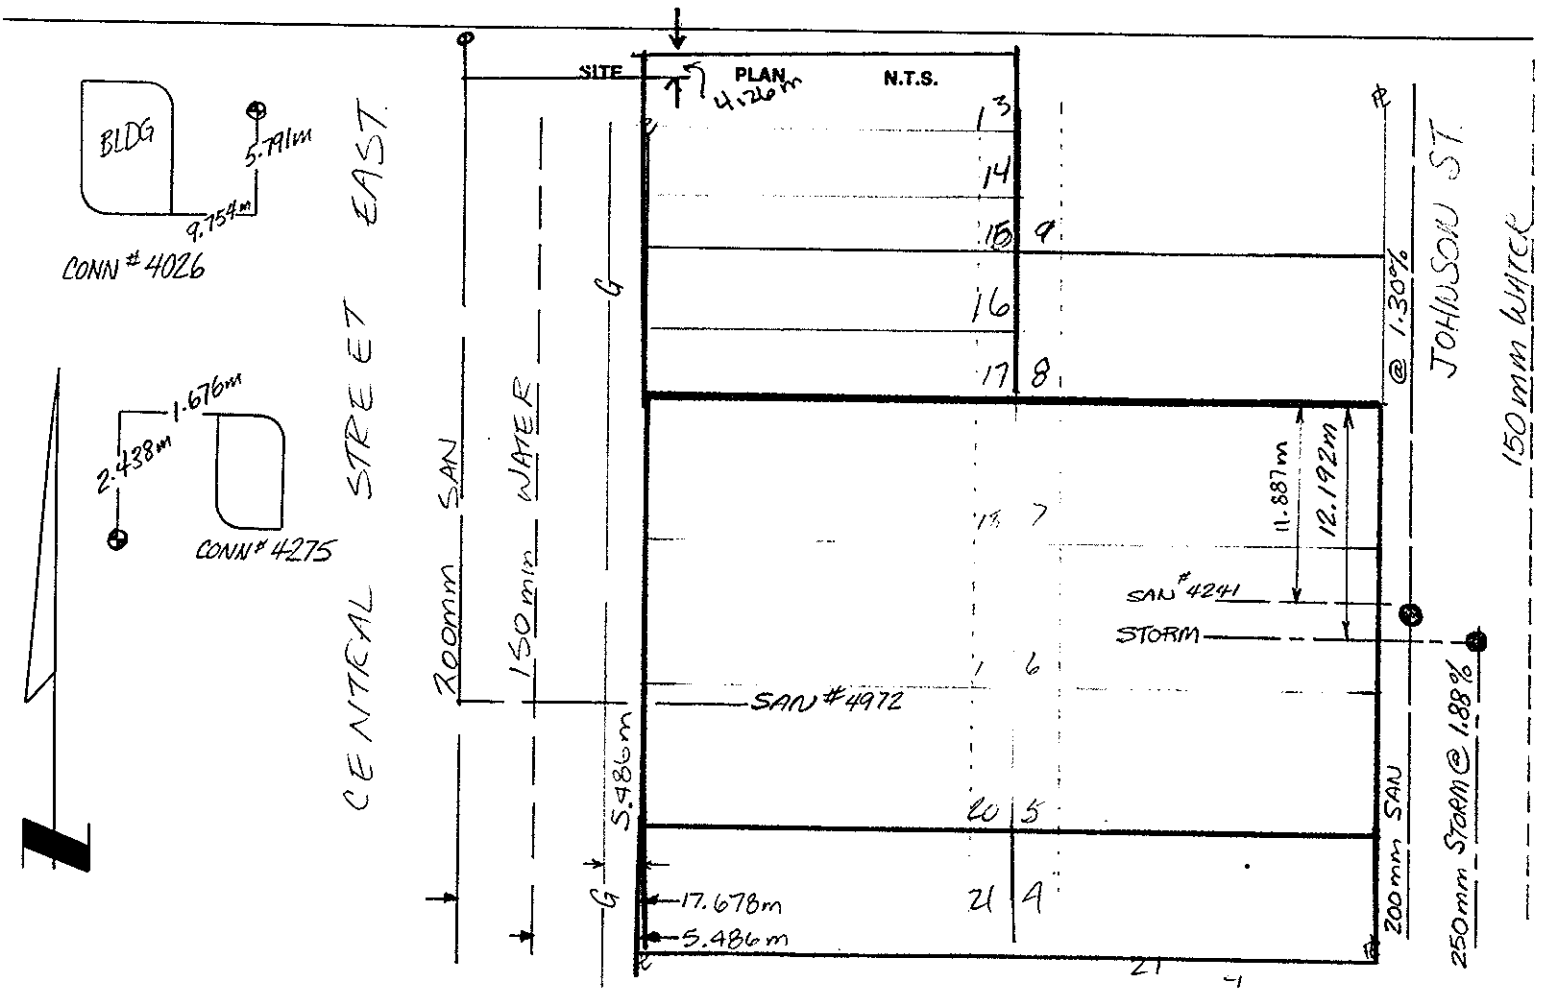
Comments: NO LOCATION ON WATER CONNECTION