# City of Prince George
## HISTORY SHEET

00818786
00818794

SHEET NUMBER 898 **Roll Number** 2571-000

**Legal:** LOT'S 17-18 BLOCK 119 D.L. 343 PLAN 1268

**Address:** 2365 LAURIER CR. PRINCE GEORGE, B.C. 2365 LAURIER CR.

**Sanitary Connection:** # 200 SIZE – MATERIAL – INV. 1922.27 CONNECTED –

**Water Connection** # 6608 SIZE 3/4" MATERIAL Cu METER – CONNECTED –

**Storm Connection:** # – SIZE MATERIAL INV. CONNECTED –

**Cash Receipt No's:** WATER 1066 SANITARY 871 STORM

CURB FROM PROPERTY LINE 16' PAVEMENT WIDTH 34'

B.C. HYDRO O.H. UNDERGROUND CONNECTION –

B.C. TELEPHONE O.H UNDERGROUND CONNECTION –

INLAND GAS IN LANE 2" ϕ MAIN.

**Information Sheets:** –

**Comments:**
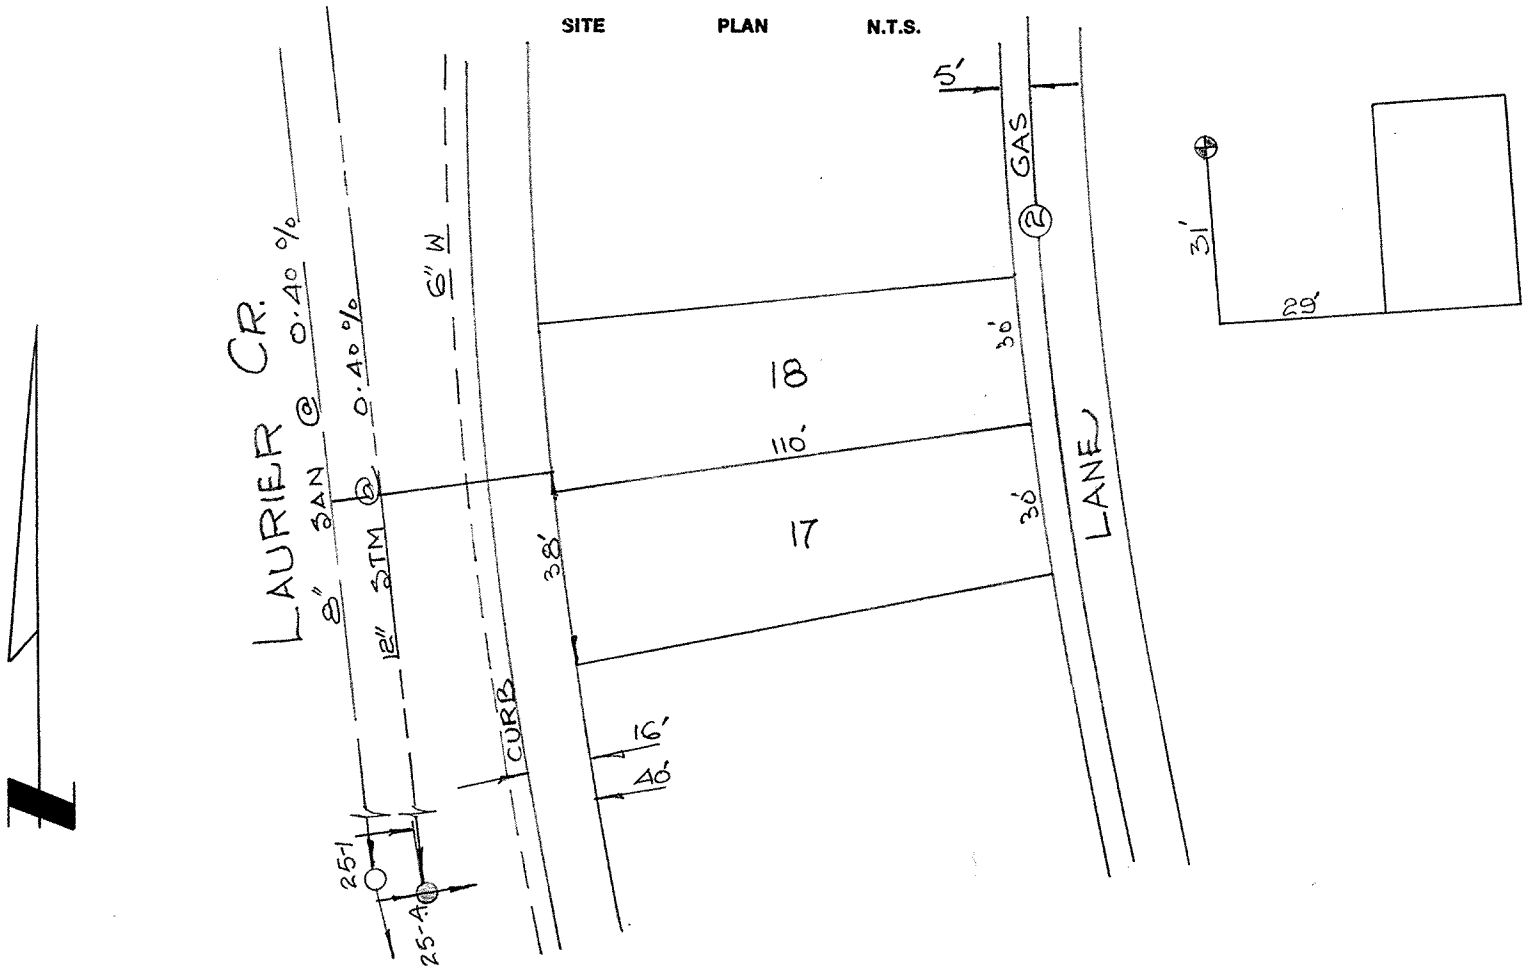
SITE PLAN N.T.S.