City of Prince George
HISTORY SHEET

608224200

SHEET NUMBER **3543** **Roll Number**

Legal: LOT'S 84 BLOCK SW 1/4 D.L. 4046 PLAN 24376

Address: 2782 Wildwood Cres

Sanitary Connection: # SIZE 100mm MATERIAL PVC INV. 35.70 CONNECTED

Water Connection # SIZE 19mm MATERIAL Cu METER CONNECTED

Storm Connection: # None SIZE MATERIAL INV. CONNECTED

Cash Receipt No's: WATER SANITARY STORM

CURB FROM PROPERTY LINE Ditch PAVEMENT WIDTH 8m

B.C. HYDRO UNDERGROUND CONNECTION

B.C. TELEPHONE UNDERGROUND CONNECTION

INLAND GAS

Information Sheets:

Comments: Bench Mark Elev. 743.713

Hyd 5 N.E Corner Ridgeview & Nixon
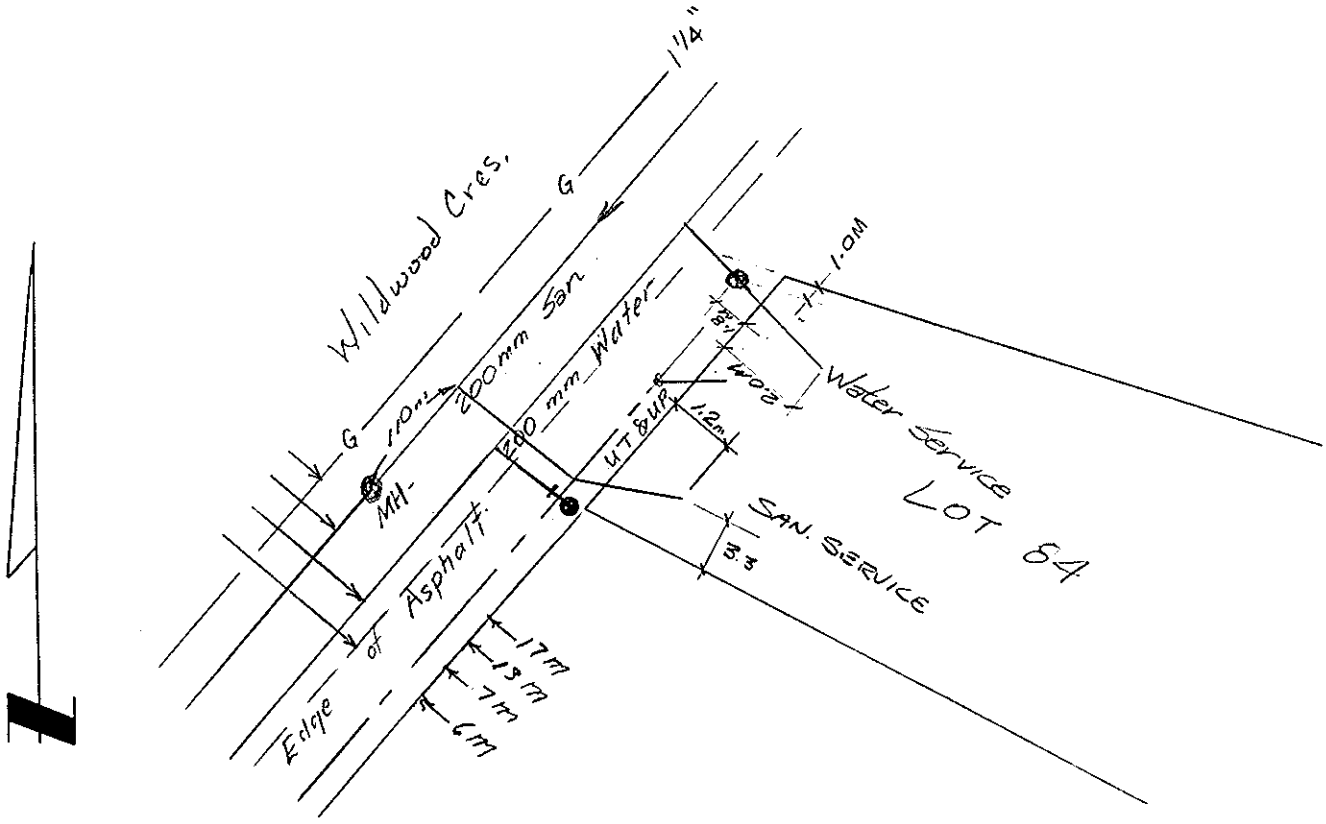
SITE PLAN N.T.S.