City of Prince George
HISTORY SHEET

SHEET NUMBER 8583 **Roll Number**

Legal: LOT'S 111 BLOCK D.L. 2013 PLAN 23118

Address: 8045 PRINCETON CRES

Sanitary Connection: # SIZE 4" MATERIAL WI PVC INV. CONNECTED

Water Connection # SIZE 3/4" MATERIAL COPPER METER CONNECTED

Storm Connection: # SIZE 4" MATERIAL GR PVC INV. CONNECTED

Cash Receipt No's: WATER SANITARY STORM

CURB FROM PROPERTY LINE 16' PAVEMENT WIDTH 34'

B.C. HYDRO 3' UNDERGROUND CONNECTION ✓

B.C. TELEPHONE 3' UNDERGROUND CONNECTION ✓

INLAND GAS 10'

Information Sheets:

Comments: 66' R/W
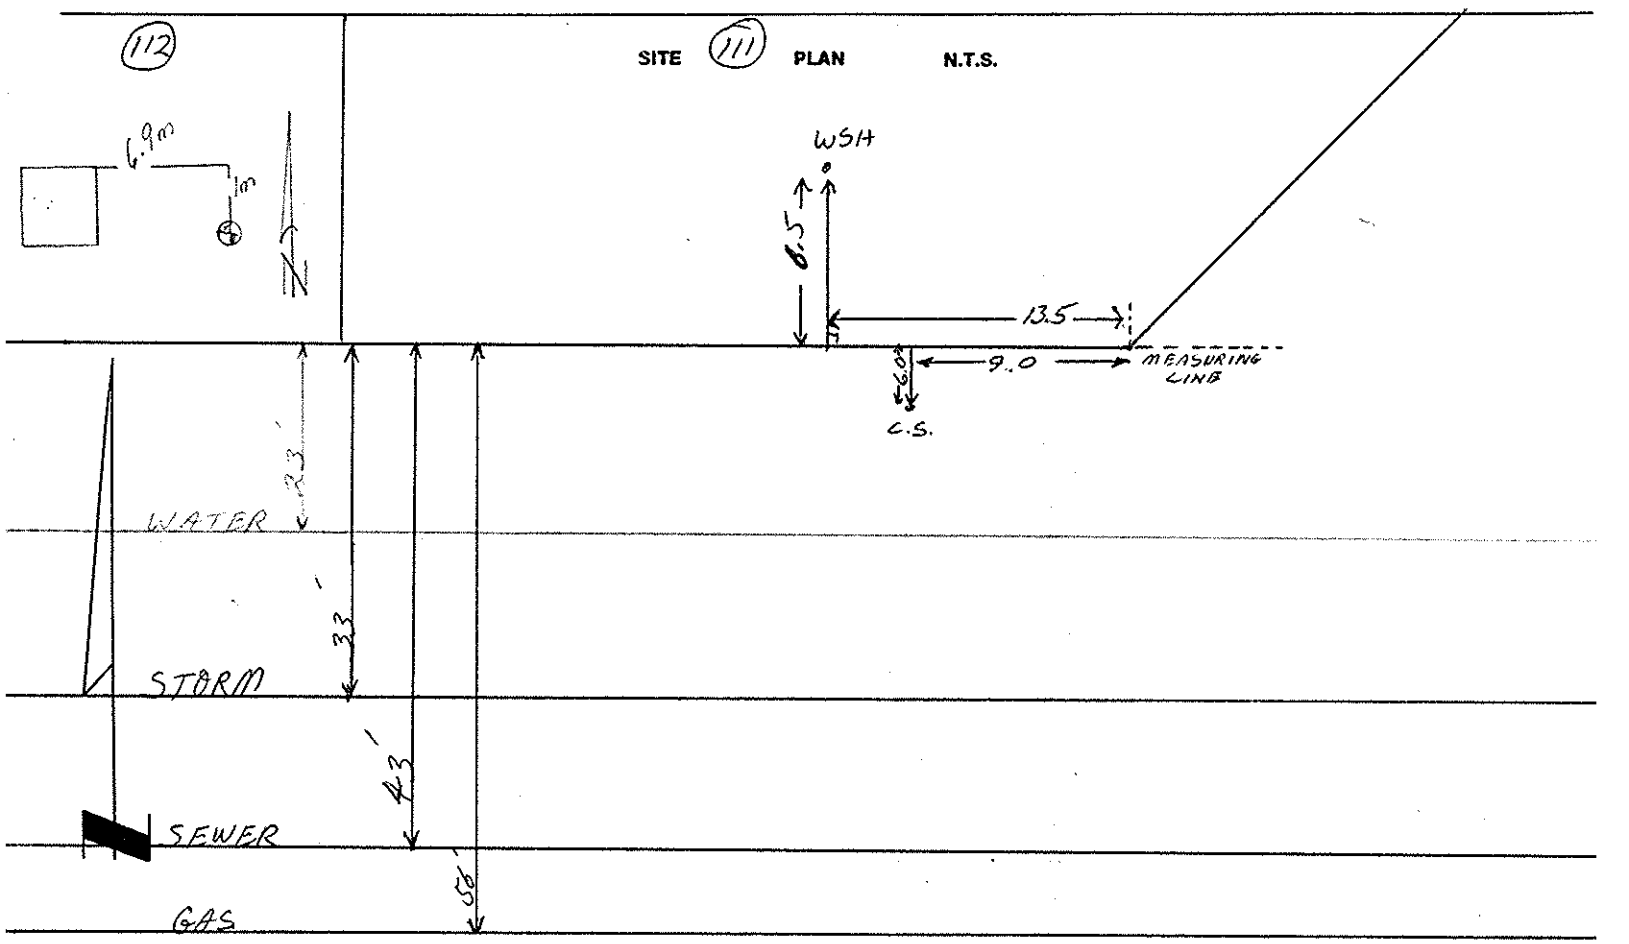
(112) SITE (111) PLAN N.T.S.