City of Prince George
HISTORY SHEET

SHEET NUMBER 3100 **Roll Number** 00827569

Legal: LOT'S 119 BLOCK D.L. 1577 PLAN 12[illegible]

Address: 7400 [illegible]

Sanitary Connection: # 16234 SIZE 100mm MATERIAL INV. CONNECTED

Water Connection # 17270 SIZE 20mm MATERIAL [illegible] METER CONNECTED

Storm Connection: # SIZE MATERIAL INV. CONNECTED

Cash Receipt No's: WATER 2032 SANITARY STORM

CURB FROM PROPERTY LINE PAVEMENT WIDTH

B.C. HYDRO UNDERGROUND CONNECTION

B.C. TELEPHONE UNDERGROUND CONNECTION

INLAND GAS as shown

Information Sheets:
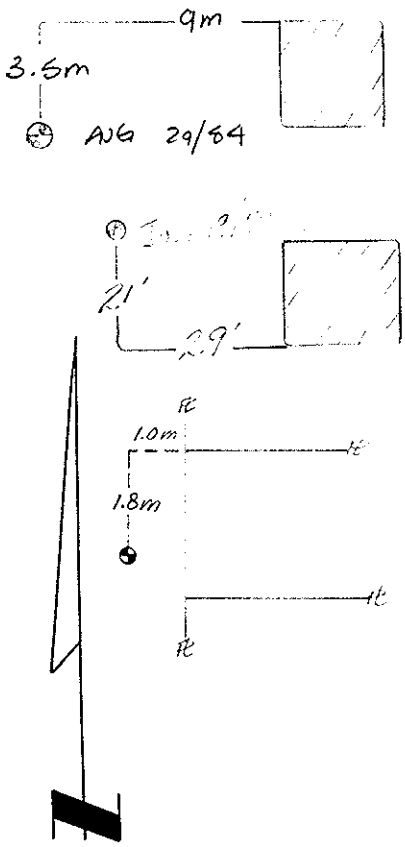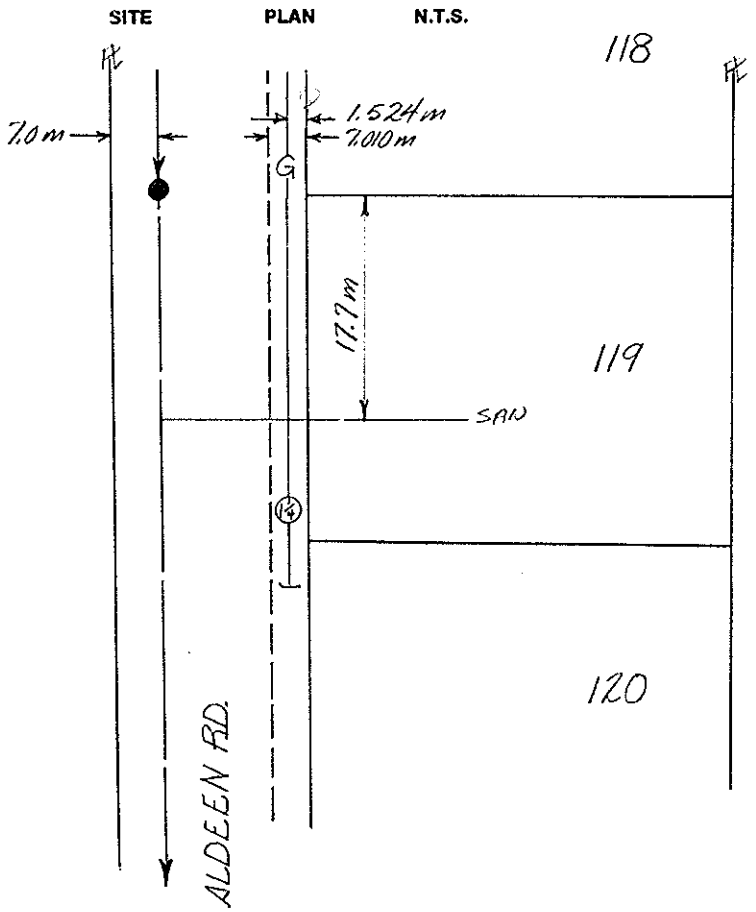
Comments: