City of Prince George
HISTORY SHEET

SHEET NUMBER 11669 **Roll Number** 308273693

Legal: LOT'S 14 BLOCK D.L. 7634 PLAN 16573

Address: 4034 STEVENS DR.

Sanitary Connection: # SIZE 100mm MATERIAL P.V.C. INV. CONNECTED

Water Connection # SIZE 20mm MATERIAL CU METER CONNECTED

Storm Connection: # SIZE MATERIAL INV. CONNECTED

Cash Receipt No's: WATER SANITARY STORM

CURB FROM PROPERTY LINE PAVEMENT WIDTH 10.00 m

B.C. HYDRO O/H UNDERGROUND CONNECTION

B.C. TELEPHONE O/H UNDERGROUND CONNECTION

INLAND GAS AS SHOWN

Information Sheets:

Comments: WATER SERVICE 5' SOUTH OF PROP. LINE

ELEV. ± 3m @ P.L. IN A PIPE
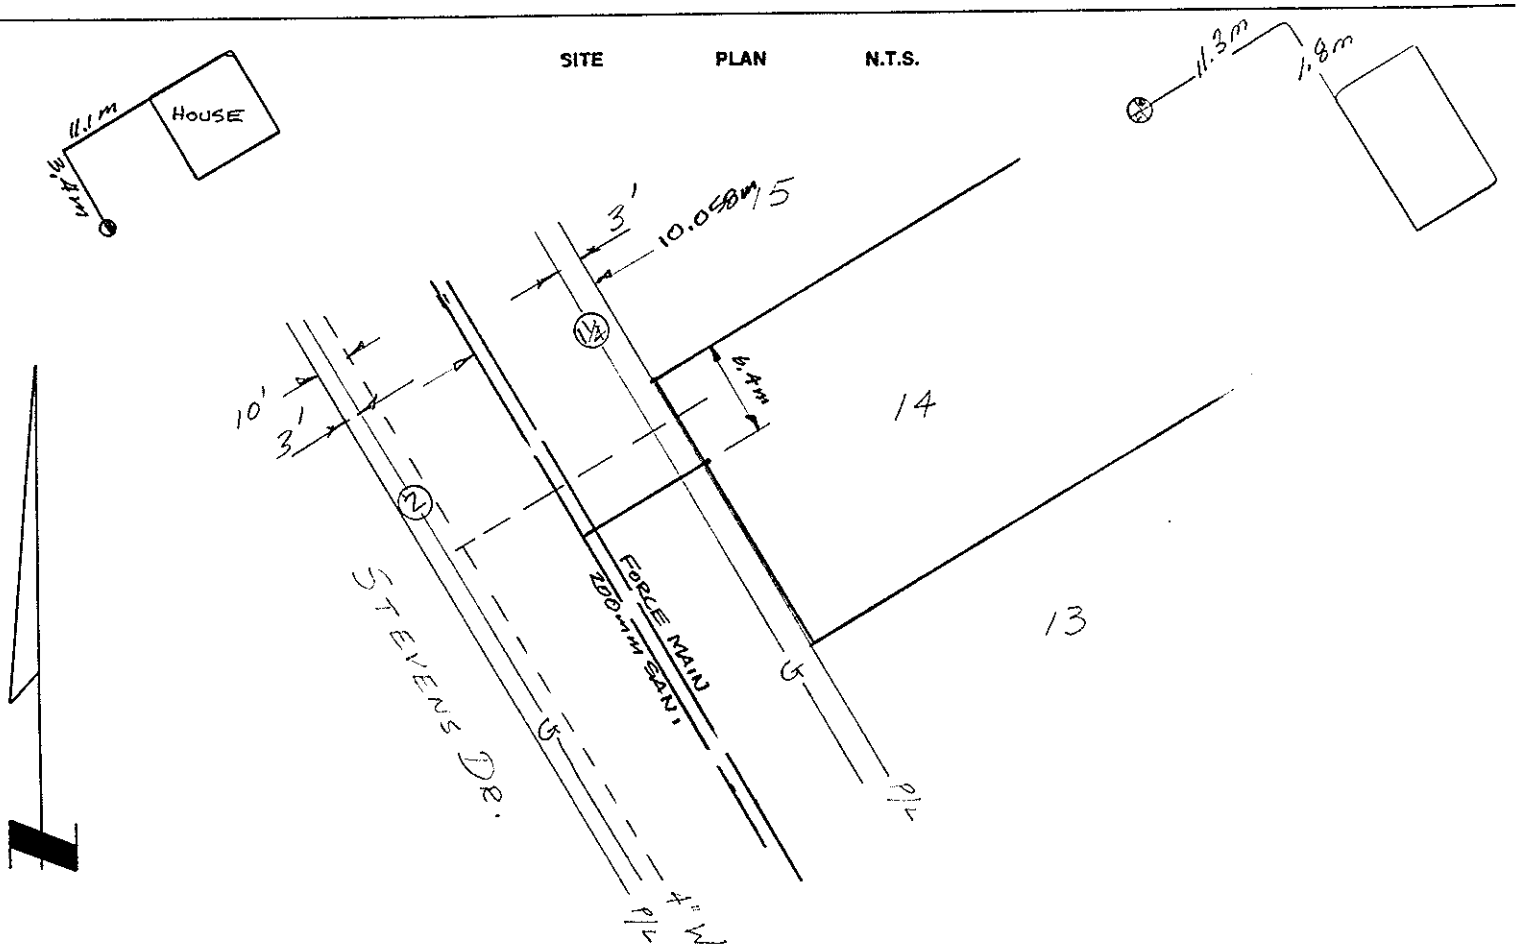
SITE PLAN N.T.S.