City of Prince George
HISTORY SHEET

308262528

ET NUMBER 1750 Roll Number

Legal: LOT'S 21 BLOCK D.L. 4046 PLAN 24336

Address: 2650 Ingata Place.

Sanitary Connection: # SIZE 4" MATERIAL PVC INV. 2413.25 CONNECTED

Water Connection # SIZE 3/4" MATERIAL copper METER CONNECTED

Storm Connection: # None SIZE MATERIAL INV. CONNECTED

Cash Receipt No's: WATER SANITARY STORM

CURB FROM PROPERTY LINE Ditch PAVEMENT WIDTH 28'

B.C. HYDRO OH UNDERGROUND CONNECTION

B.C. TELEPHONE OH UNDERGROUND CONNECTION

INLAND GAS

Information Sheets:

Comments: B.M. Hyd. spin. N.W. Cor. Croft & Oakridge 2385.43 city # 1979
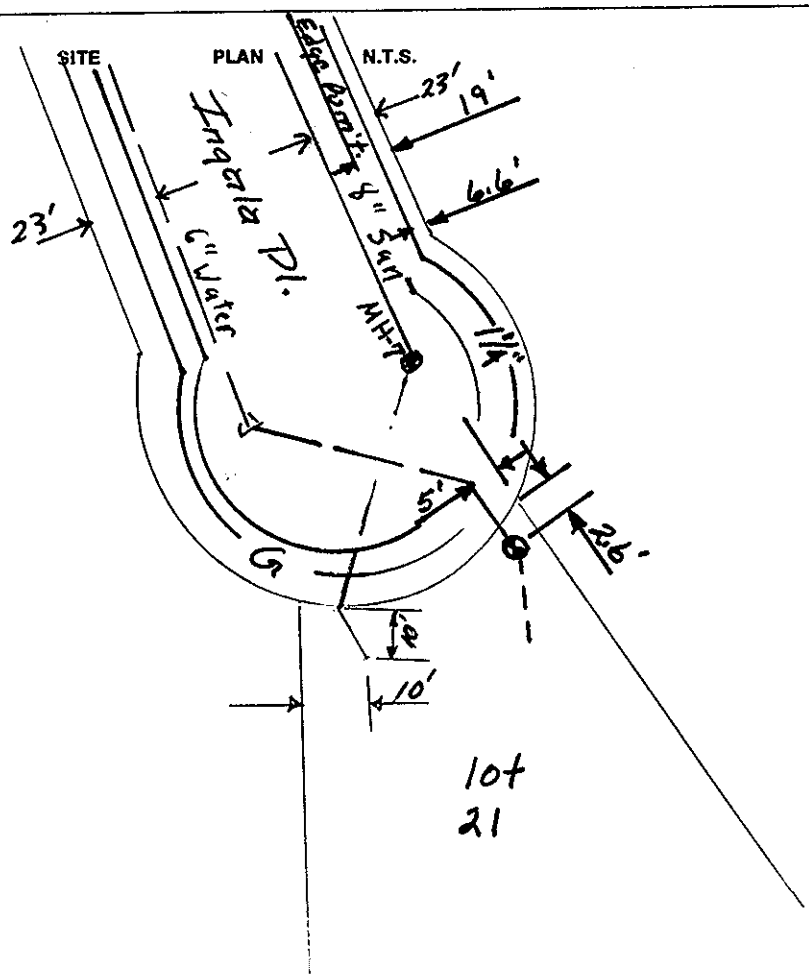
SITE PLAN N.T.S.