City of Prince George
HISTORY SHEET

608282731

EET NUMBER 1726 **Roll Number**

Legal: LOT'S 22 BLOCK D.L. 4046 PLAN 24336

Address: 2625 INGALA PLACE

Sanitary Connection: # SIZE 4" MATERIAL PVC INV. 2412.96 CONNECTED

Water Connection # SIZE 3/4" MATERIAL Copper METER CONNECTED

Storm Connection: # None SIZE MATERIAL INV. CONNECTED

Cash Receipt No's: WATER SANITARY STORM

CURB FROM PROPERTY LINE Ditch PAVEMENT WIDTH 28'

B.C. HYDRO ON UNDERGROUND CONNECTION

B.C. TELEPHONE ON UNDERGROUND CONNECTION

INLAND GAS

THE INFORMATION CONTAINED HEREIN IS FOR INTERNAL USE ONLY. NOT TO BE RELIED UPON UNLESS CONFIRMED BY SITE INSPECTION AND/OR INVESTIGATION.

Information Sheets:

Comments: B.M. Hyd. spin. N.W. Cor. Croft & Oakridge 2385.43 city # 1979
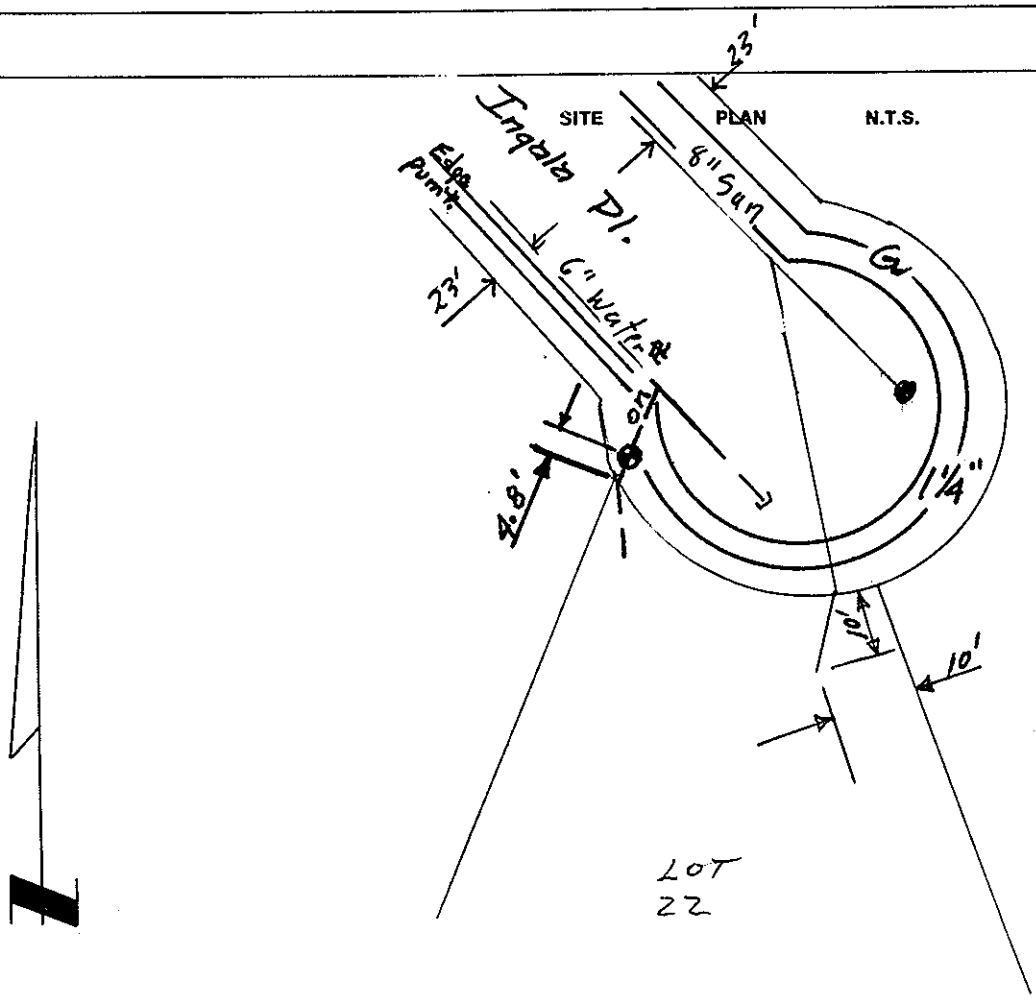
SITE PLAN N.T.S.