City of Prince George
HISTORY SHEET

SHEET NUMBER **Roll Number** 008283133

Legal: LOT'S 35 BLOCK D.L. 753 PLAN 24319

Address: 3235 MONAHAN CRES.

Sanitary Connection: # SIZE 4" MATERIAL WHITE P.V.C. INV. CONNECTED

Water Connection # SIZE 3/4" MATERIAL COPPER METER CONNECTED

Storm Connection: # SIZE 4" MATERIAL GREY P.V.C. INV. CONNECTED

Cash Receipt No's: WATER SANITARY STORM

CURB FROM PROPERTY LINE 5.058 M. PAVEMENT WIDTH 10 M.

B.C. HYDRO 1 M. UNDERGROUND CONNECTION [redacted]

B.C. TELEPHONE 1 M. UNDERGROUND CONNECTION [redacted]

INLAND GAS 3 M.

Information Sheets:

Comments: 20.116 M. R/W
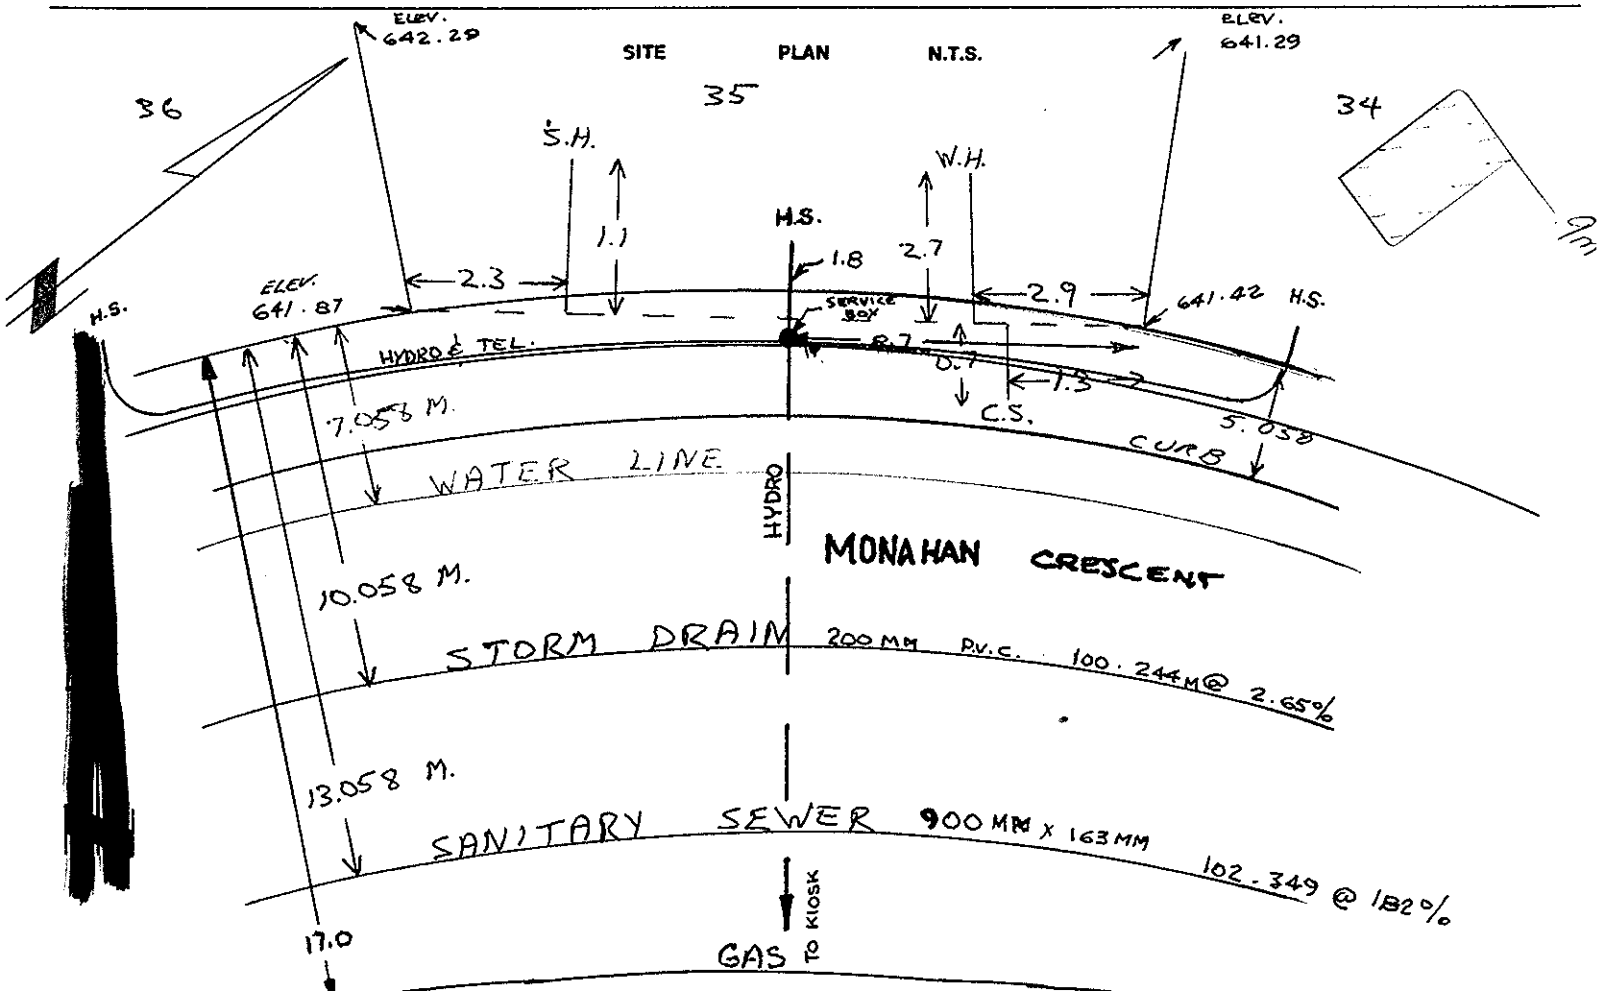
SITE PLAN N.T.S.