City of Prince George
HISTORY SHEET

JK

SHEET NUMBER **Roll Number**

Legal: LOT'S 40 BLOCK D.L. 934 PLAN 24282

Address: 2509 MOSS AVE.

Sanitary Connection: # SIZE 4" MATERIAL A.C. INV. 74.80 CONNECTED

Water Connection # SIZE 3/4" MATERIAL C.U. METER CONNECTED

Storm Connection: # SIZE 4" MATERIAL A.C. INV. 76.62 CONNECTED

Cash Receipt No's: WATER SANITARY STORM

CURB FROM PROPERTY LINE 5m (ROLL CURB) PAVEMENT WIDTH 10 m

B.C. HYDRO UNDERGROUND CONNECTION

B.C. TELEPHONE UNDERGROUND CONNECTION

INLAND GAS

Information Sheets:

The information contained herein is for internal use only. Not to be relied upon unless confirmed by site inspection and/or investigation.

Comments: BM H.N. N.W. CORNER MOSS & NORWOOD

HYD # 1421 576.000

LEV. BK. # 372
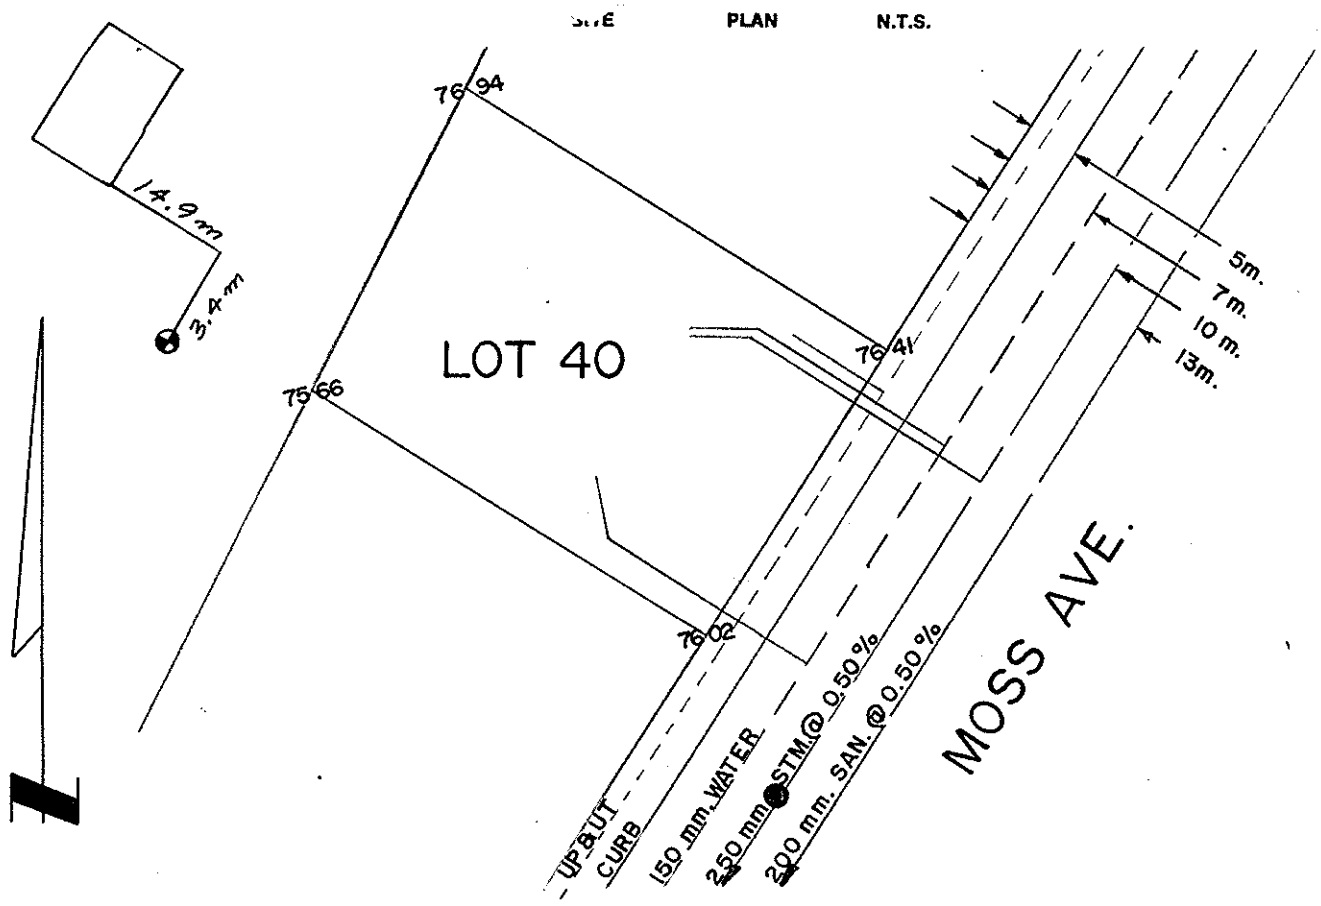
SITE PLAN N.T.S.