City of Prince George
HISTORY SHEET

JJ

SHEET NUMBER | **Roll Number**

Legal: LOT'S 47 BLOCK D.L. 933 & 934 PLAN 24282

Address: 2593 MOSS AVE.

Sanitary Connection: # SIZE 4" MATERIAL A.C. INV. 73.88 CONNECTED

Water Connection # SIZE 3/4" MATERIAL C.U. METER CONNECTED

Storm Connection: # SIZE 4" MATERIAL A.C. INV. 73.87 CONNECTED

Cash Receipt No's: WATER SANITARY STORM

CURB FROM PROPERTY LINE 5m (ROLL CURB) PAVEMENT WIDTH 10 m

B.C. HYDRO UNDERGROUND CONNECTION

B.C. TELEPHONE UNDERGROUND CONNECTION

INLAND GAS

Information Sheets:

Comments: B.M. H.N. N.W. CORNER MOSS & NORWOOD
HYD. # 1421 576000

LEV. BK. # 3721
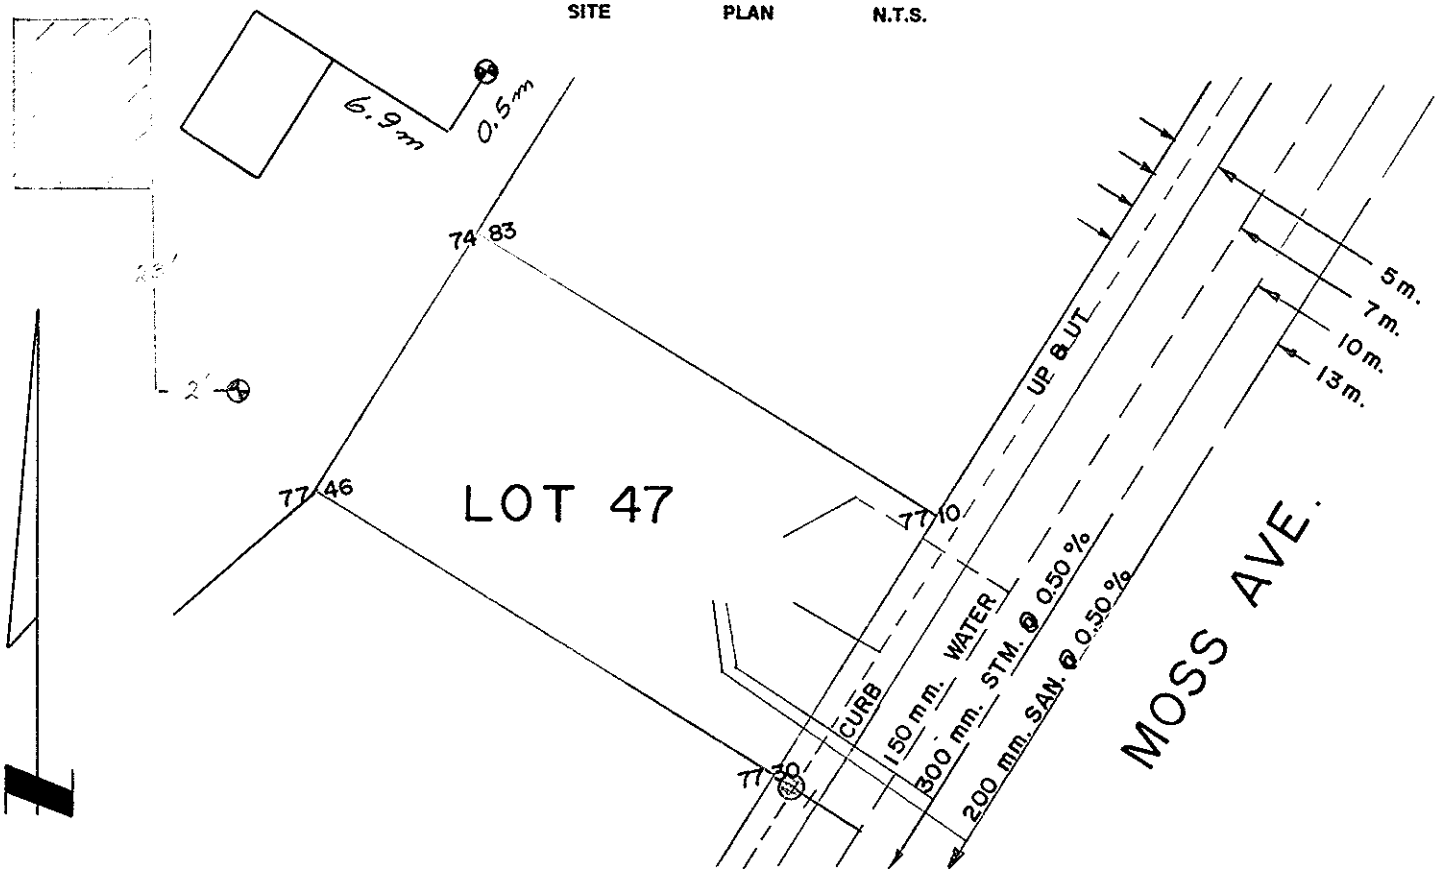
SITE PLAN N.T.S.