City of Prince George
HISTORY SHEET

G083/9/54

SHEET NUMBER | **Roll Number**

Legal: LOT'S A BLOCK D.L. 4046 PLAN 24244

Address: 5730 COOK CRES.

Sanitary Connection: # 13405 SIZE 4" MATERIAL INV. CONNECTED

Water Connection # SIZE 3/4" MATERIAL Copper METER CONNECTED

Storm Connection: # SIZE MATERIAL INV. CONNECTED

Cash Receipt No's: WATER SANITARY STORM

CURB FROM PROPERTY LINE PAVEMENT WIDTH

B.C. HYDRO UNDERGROUND CONNECTION

B.C. TELEPHONE UNDERGROUND CONNECTION

INLAND GAS

Information Sheets:

Comments:
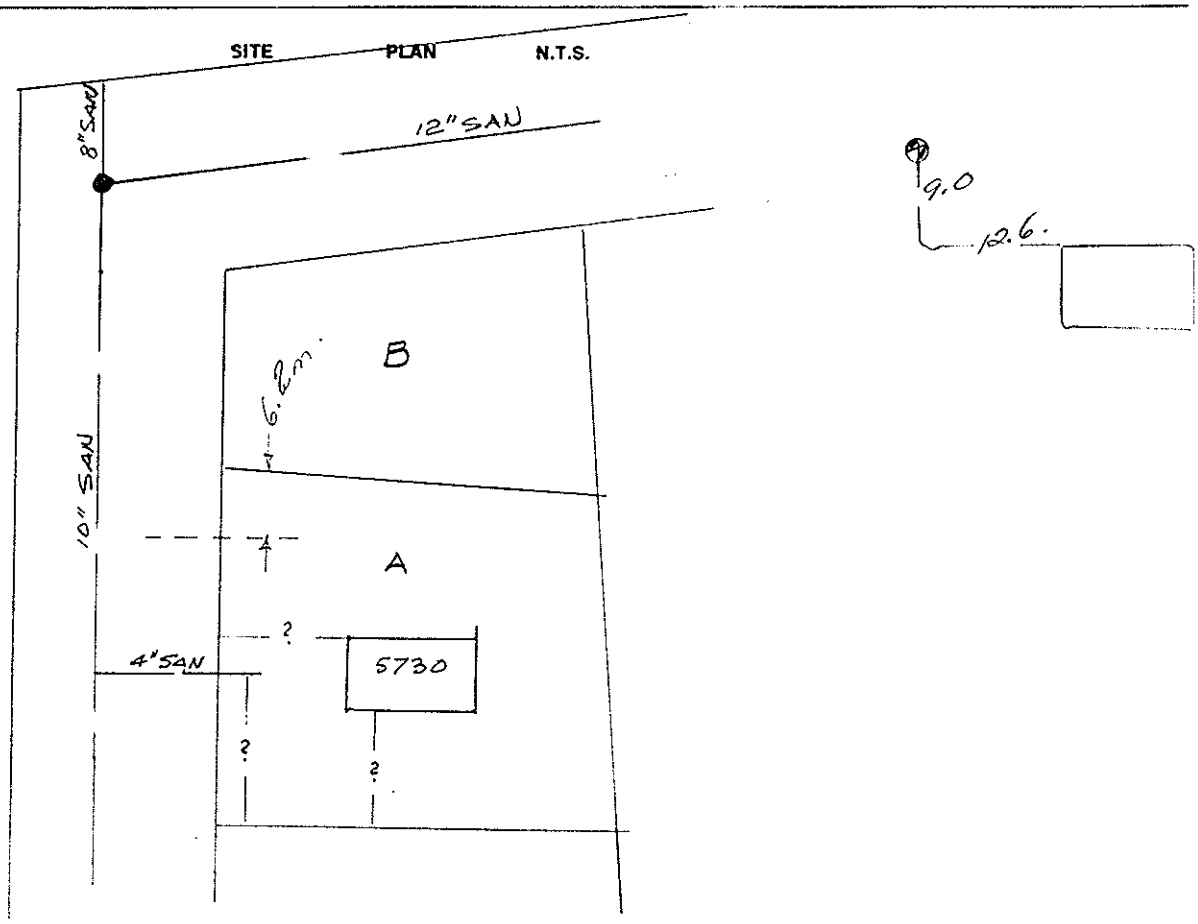
SITE PLAN N.T.S.