City of Prince George
HISTORY SHEET

0083706 48

SHEET NUMBER № 2584 **Roll Number**

Legal: LOT'S 3 BLOCK D.L. 913 PLAN 19466

Address: 1532 VAN BIEN

Sanitary Connection: # 12663 SIZE 100MM MATERIAL INV. CONNECTED

Water Connection # 11140 SIZE 3/4" MATERIAL Cu. METER CONNECTED

Storm Connection: # SIZE MATERIAL INV. CONNECTED

Cash Receipt No's: WATER SANITARY STORM

CURB FROM PROPERTY LINE 4.88 PAVEMENT WIDTH 5.18

B.C. HYDRO O.H. UNDERGROUND CONNECTION

B.C. TELEPHONE O.H. UNDERGROUND CONNECTION

INLAND GAS AS SHOWN.

Information Sheets:

Comments:

1972

5'

CENTRE OF LOT
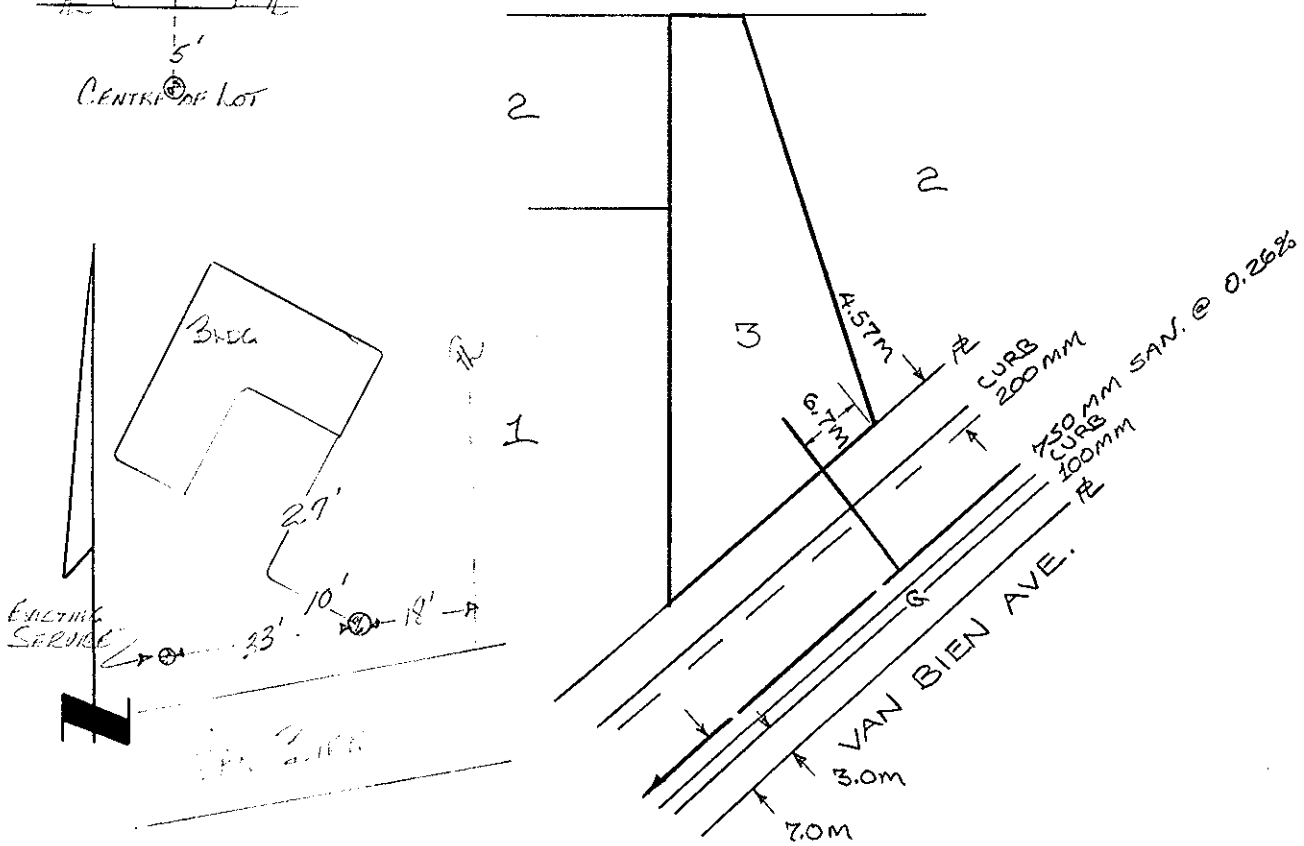
SITE PLAN N.T.S.