City of Prince George
HISTORY SHEET

SHEET NUMBER

Roll Number 896

Legal: LOT'S 20-21 BLOCK 111 D.L. 938 PLAN 752

Address: 134 N. Lyon

Sanitary Connection: # 3070 SIZE MATERIAL INV. CONNECTED

Water Connection # 3226 SIZE 20mm MATERIAL Cu METER CONNECTED

Storm Connection: # SIZE MATERIAL INV. CONNECTED

Cash Receipt No's: WATER SANITARY STORM

CURB FROM PROPERTY LINE PAVEMENT WIDTH

B.C. HYDRO UNDERGROUND CONNECTION

B.C. TELEPHONE UNDERGROUND CONNECTION

INLAND GAS

Information Sheets: THE INFORMATION CONTAINED HEREIN IS FOR INTERNAL USE ONLY. NOT TO BE RELIED UPON UNLESS CONFIRMED BY SITE INSPECTION AND/OR INVESTIGATION.

Comments:

8.9m

5.6m
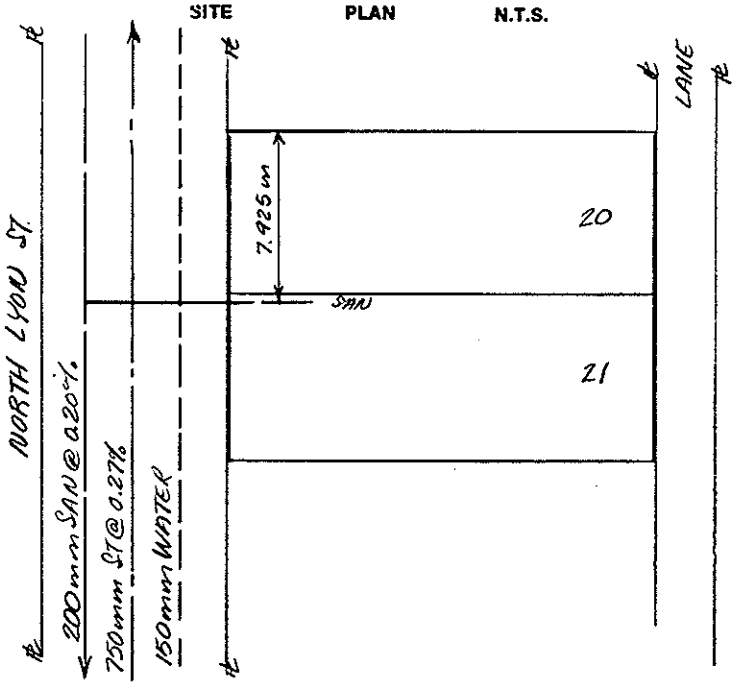
SITE PLAN N.T.S.