City of Prince George
HISTORY SHEET

00842496 9
00842498 5

SHEET NUMBER **Roll Number**

Legal: LOT'S 13-14 BLOCK 10 D.L. 938 PLAN 752

Address: 3455 HAMMOND AVE

Sanitary Connection: # 3207 SIZE MATERIAL INV. CONNECTED

Water Connection # 3136 SIZE 150mm MATERIAL Cu METER CONNECTED

Storm Connection: # SIZE MATERIAL INV. CONNECTED

Cash Receipt No's: WATER SANITARY STORM

CURB FROM PROPERTY LINE PAVEMENT WIDTH

B.C. HYDRO UNDERGROUND CONNECTION

B.C. TELEPHONE UNDERGROUND CONNECTION

INLAND GAS

Information Sheets:
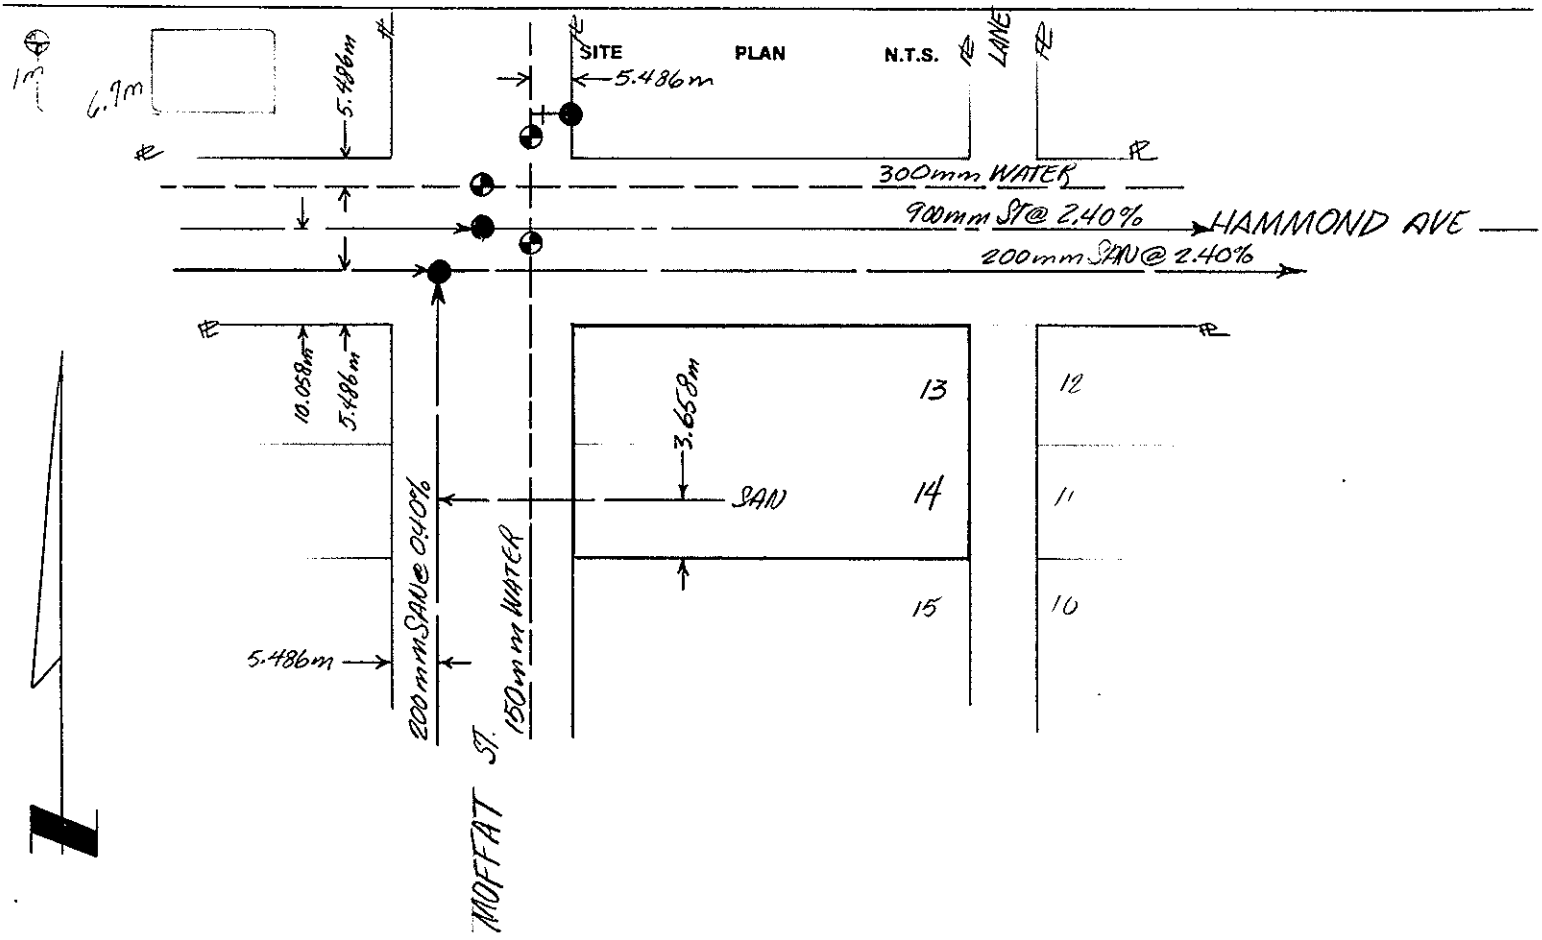
Comments: