City of Prince George
HISTORY SHEET

SHEET NUMBER **Roll Number**

Legal: LOT'S 7-8 BLOCK 103 D.L. 937 PLAN 42

Address: 161 Nicholson St

Sanitary Connection: # 3300 SIZE MATERIAL INV. CONNECTED

Water Connection # 3335 SIZE 20mm MATERIAL Cu METER CONNECTED

Storm Connection: # SIZE MATERIAL INV. CONNECTED

Cash Receipt No's: WATER SANITARY 1199 STORM

CURB FROM PROPERTY LINE 4.8m PAVEMENT WIDTH 10.9m

B.C. HYDRO UNDERGROUND CONNECTION

B.C. TELEPHONE UNDERGROUND CONNECTION

INLAND GAS

Information Sheets:

Comments:

10.8m 2m
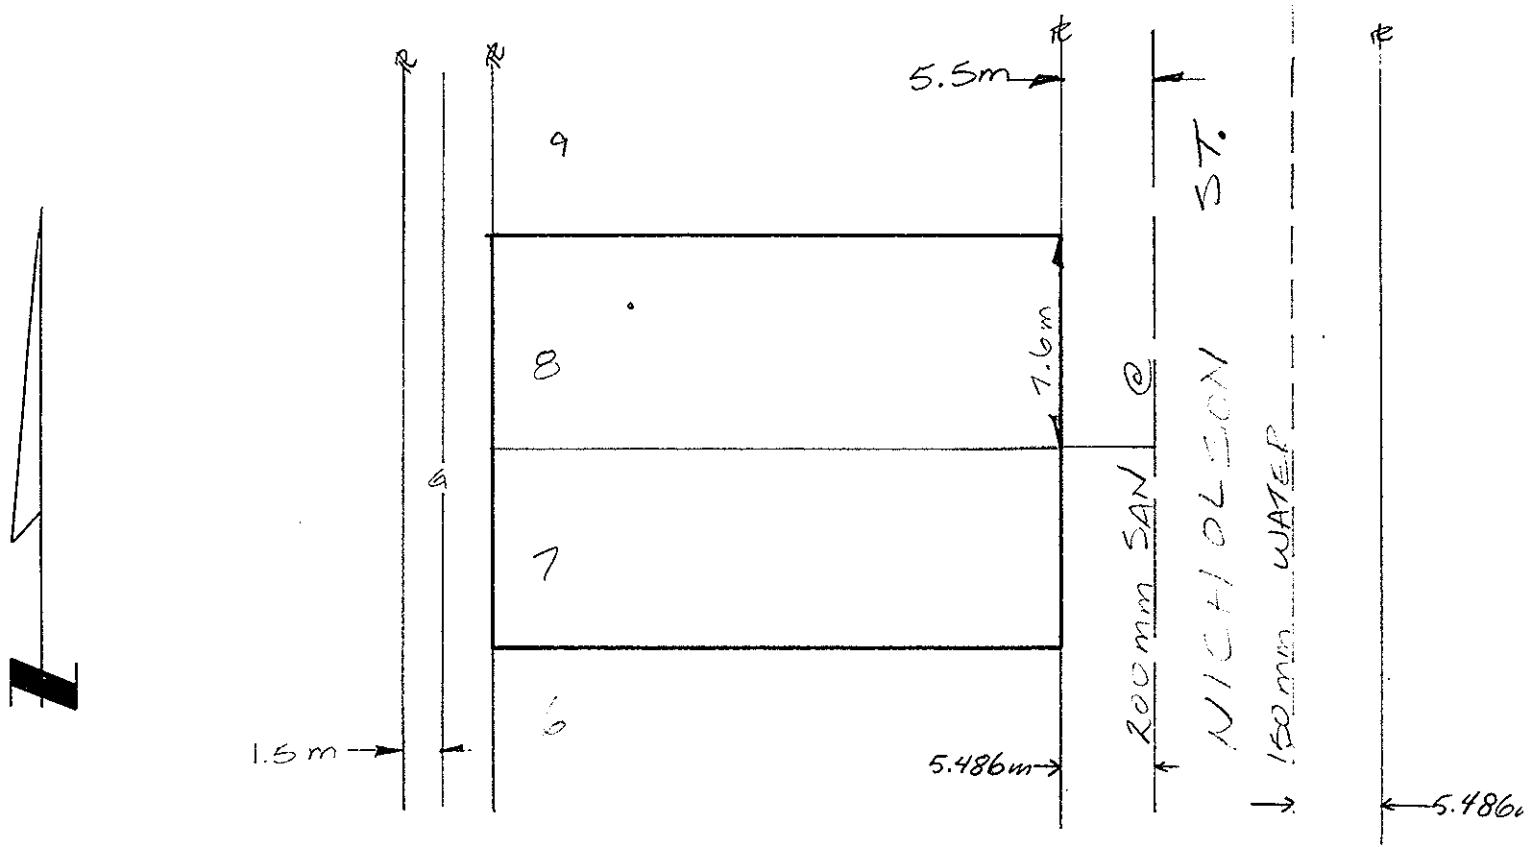
SITE PLAN N.T.S.