City of Prince George
HISTORY SHEET

SHEET NUMBER **Roll Number** 008443629

Legal: LOT'S 1 BLOCK D.L. 754 PLAN 23862

Address: 7515 ST. LAWRENCE

Sanitary Connection: # SIZE 4" MATERIAL P.V.C. INV. CONNECTED

Water Connection # SIZE 3/4" MATERIAL COPPER METER CONNECTED

Storm Connection: # SIZE 4" MATERIAL P.V.C. INV. CONNECTED

Cash Receipt No's: WATER SANITARY STORM

CURB FROM PROPERTY LINE 12' PAVEMENT WIDTH 42'

B.C. HYDRO 3' UNDERGROUND CONNECTION ✓

B.C. TELEPHONE 3' UNDERGROUND CONNECTION ✓

INLAND GAS 10'

Information Sheets:
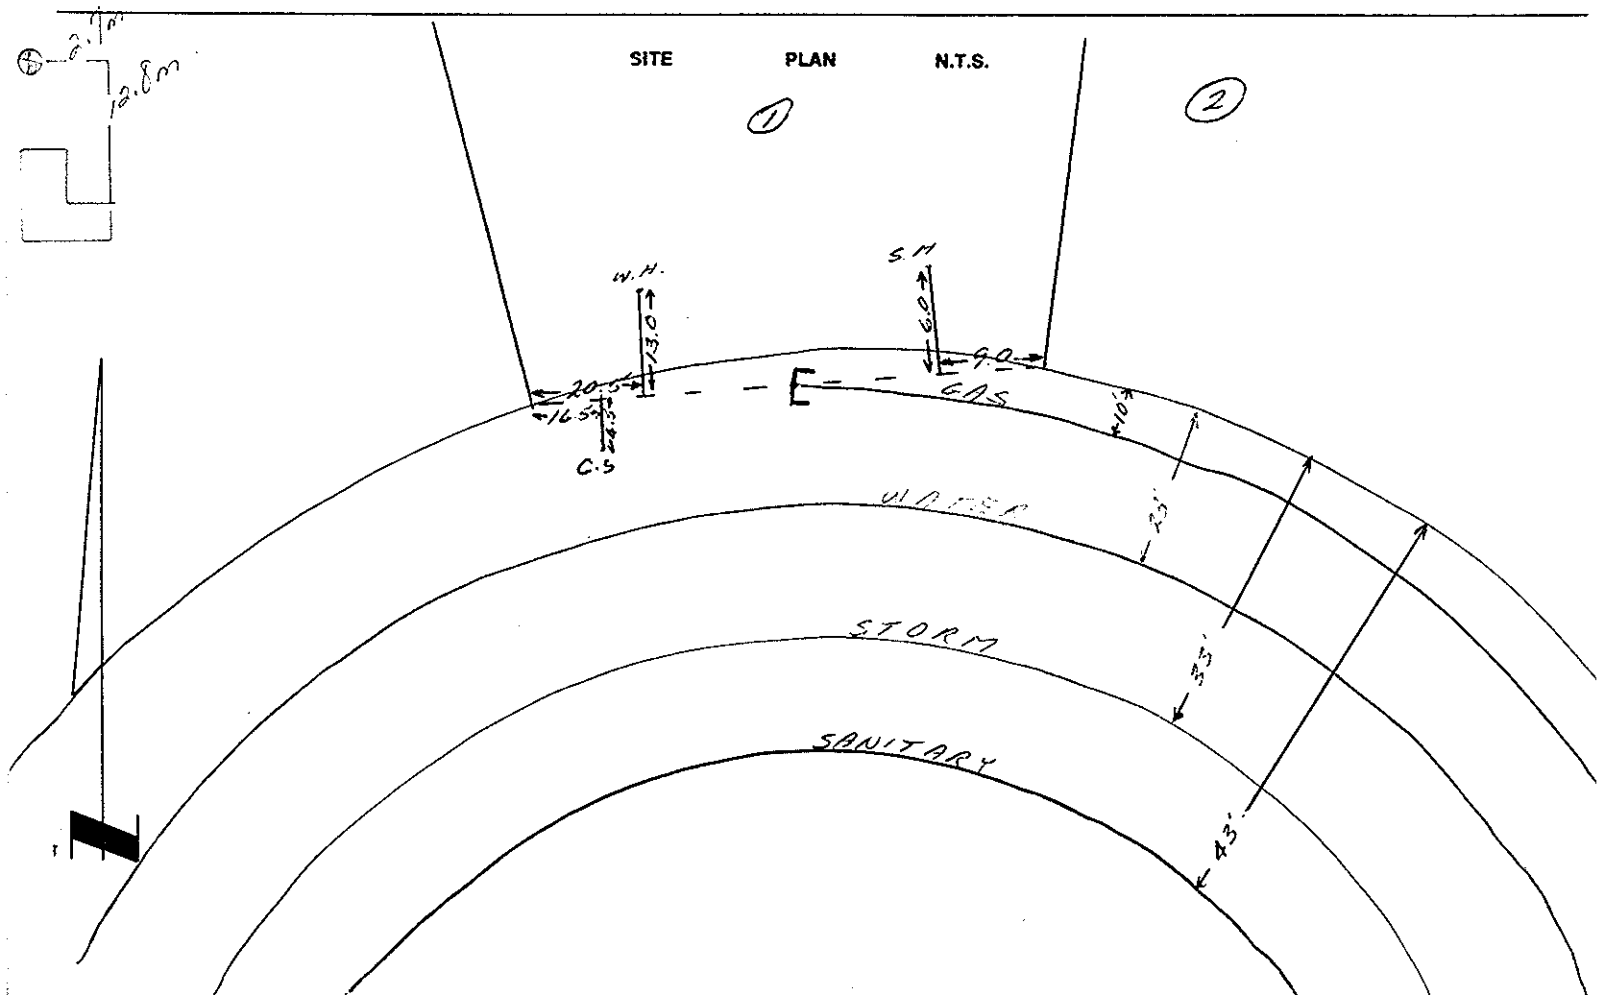
Comments: 66' R/W