City of Prince George
HISTORY SHEET

SHEET NUMBER **Roll Number**

Legal: LOT'S 5-7 BLOCK 121 D.L. 332 PLAN 332

Address: 355 N. Lion

Sanitary Connection: # 3228 SIZE MATERIAL INV. CONNECTED

Water Connection # 3269 SIZE 20mm MATERIAL Cu METER CONNECTED

Storm Connection: # SIZE MATERIAL INV. CONNECTED

Cash Receipt No's: WATER SANITARY STORM

CURB FROM PROPERTY LINE PAVEMENT WIDTH

B.C. HYDRO UNDERGROUND CONNECTION

B.C. TELEPHONE UNDERGROUND CONNECTION

INLAND GAS

Information Sheets:
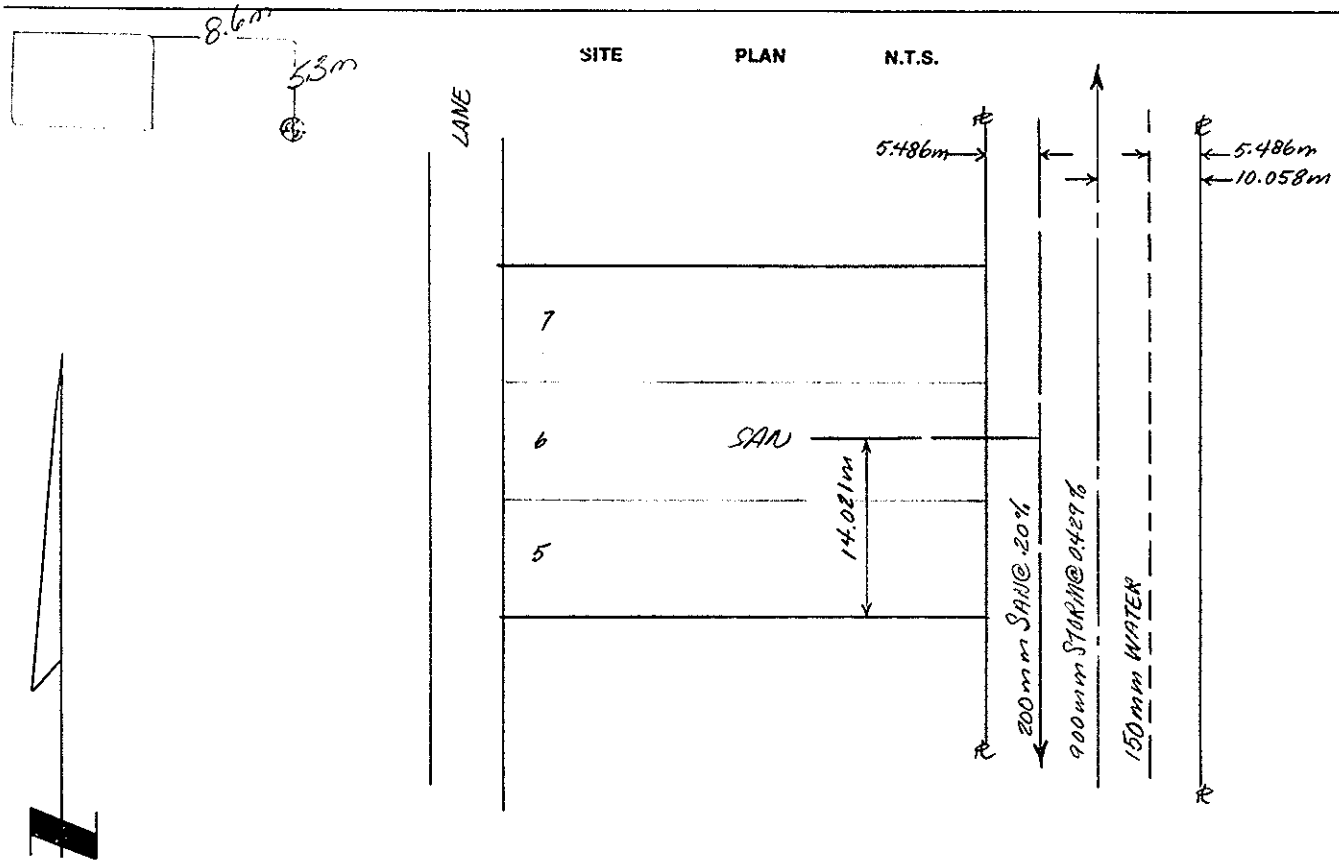
Comments: