City of Prince George
HISTORY SHEET

3084156 Loc

SHEET NUMBER

Roll Number 976

Legal: LOT'S 3-4 BLOCK 131 D.L. 938 PLAN 752

Address: 321 Nicholson St

Sanitary Connection: # 3402 SIZE MATERIAL INV. CONNECTED

Water Connection # 3379 SIZE 20mm MATERIAL Cu METER CONNECTED

Storm Connection: # SIZE MATERIAL INV. CONNECTED

Cash Receipt No's: WATER SANITARY STORM

CURB FROM PROPERTY LINE PAVEMENT WIDTH

B.C. HYDRO UNDERGROUND CONNECTION

B.C. TELEPHONE UNDERGROUND CONNECTION

INLAND GAS

Information Sheets:

Comments:

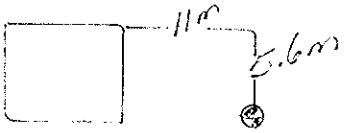
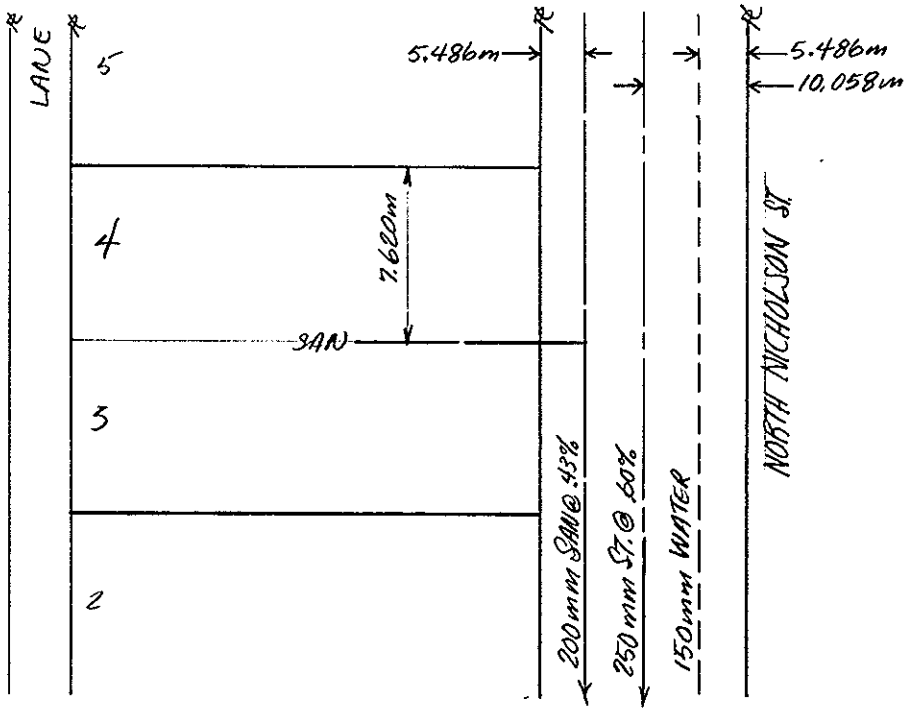
SITE PLAN N.T.S.