City of Prince George
HISTORY SHEET

D5

SHEET NUMBER **5160** Roll Number 008457492

Legal: LOT'S 1 BLOCK D.L. 751 PLAN 23529

Address: SANTA FE RD. 9359 Milwaukee Way ✓

Sanitary Connection: # 12365 SIZE 100mm MATERIAL C.I. INV. 582.121 CONNECTED

Water Connection # 11460 / 12363 SIZE 4" / 150mm MATERIAL C.I. METER CONNECTED

Storm Connection: # 1217 SIZE 300mm MATERIAL INV. 582.028 CONNECTED

Cash Receipt No's: WATER 1565 #11460 - 0655 SANITARY 1566 STORM 427

CURB FROM PROPERTY LINE PAVEMENT WIDTH

B.C. HYDRO O.H. UNDERGROUND CONNECTION

B.C. TELEPHONE O.H. UNDERGROUND CONNECTION

INLAND GAS AS SHOWN.

Information Sheets:

Comments:
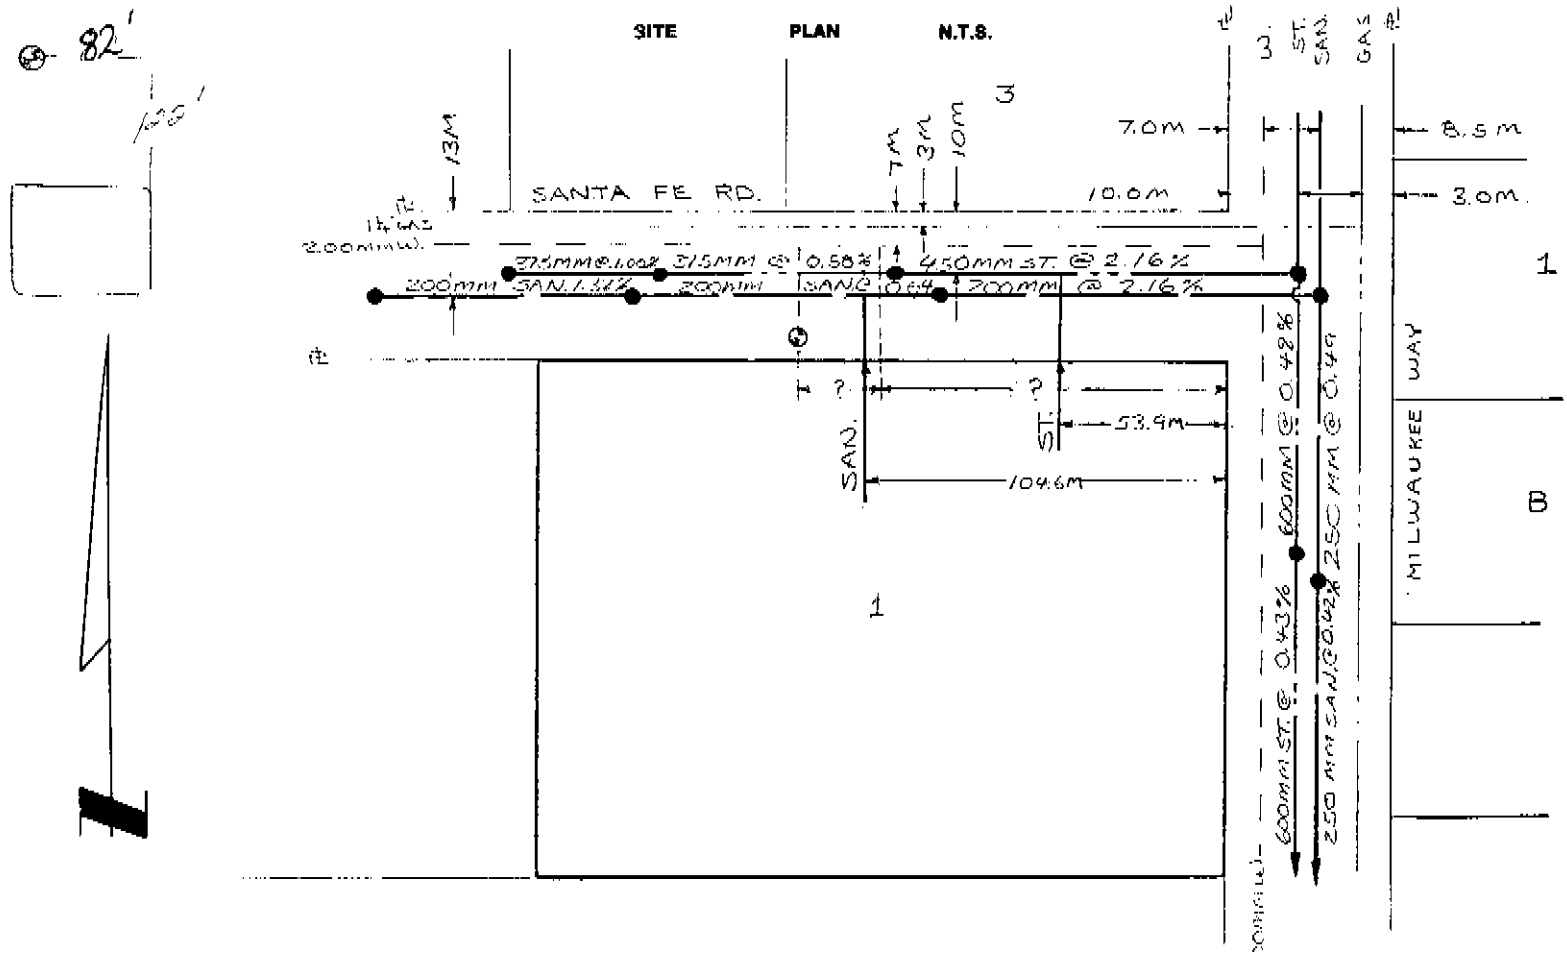
SITE PLAN N.T.S.