City of Prince George
HISTORY SHEET

SHEET NUMBER **4691** Roll Number 008468478

Legal: LOT'S 7 BLOCK D.L. 8174 PLAN 23799

Address: 3630 GOULD CRES.

Sanitary Connection: # SIZE 4" MATERIAL A.C. INV. 51.14 CONNECTED

Water Connection # SIZE 3/4" MATERIAL CU. METER CONNECTED

Storm Connection: # SIZE MATERIAL INV. CONNECTED

Cash Receipt No's: WATER SANITARY STORM

CURB FROM PROPERTY LINE 16' (ROLL CURB) PAVEMENT WIDTH 34'

B.C. HYDRO UNDERGROUND CONNECTION

B.C. TELEPHONE UNDERGROUND CONNECTION

INLAND GAS

Information Sheets:

Comments: BENCH MARK ELEV. 1955.25

S.W. COR. OSPIKA & GOULD S.LEC

LEV. BK. #333
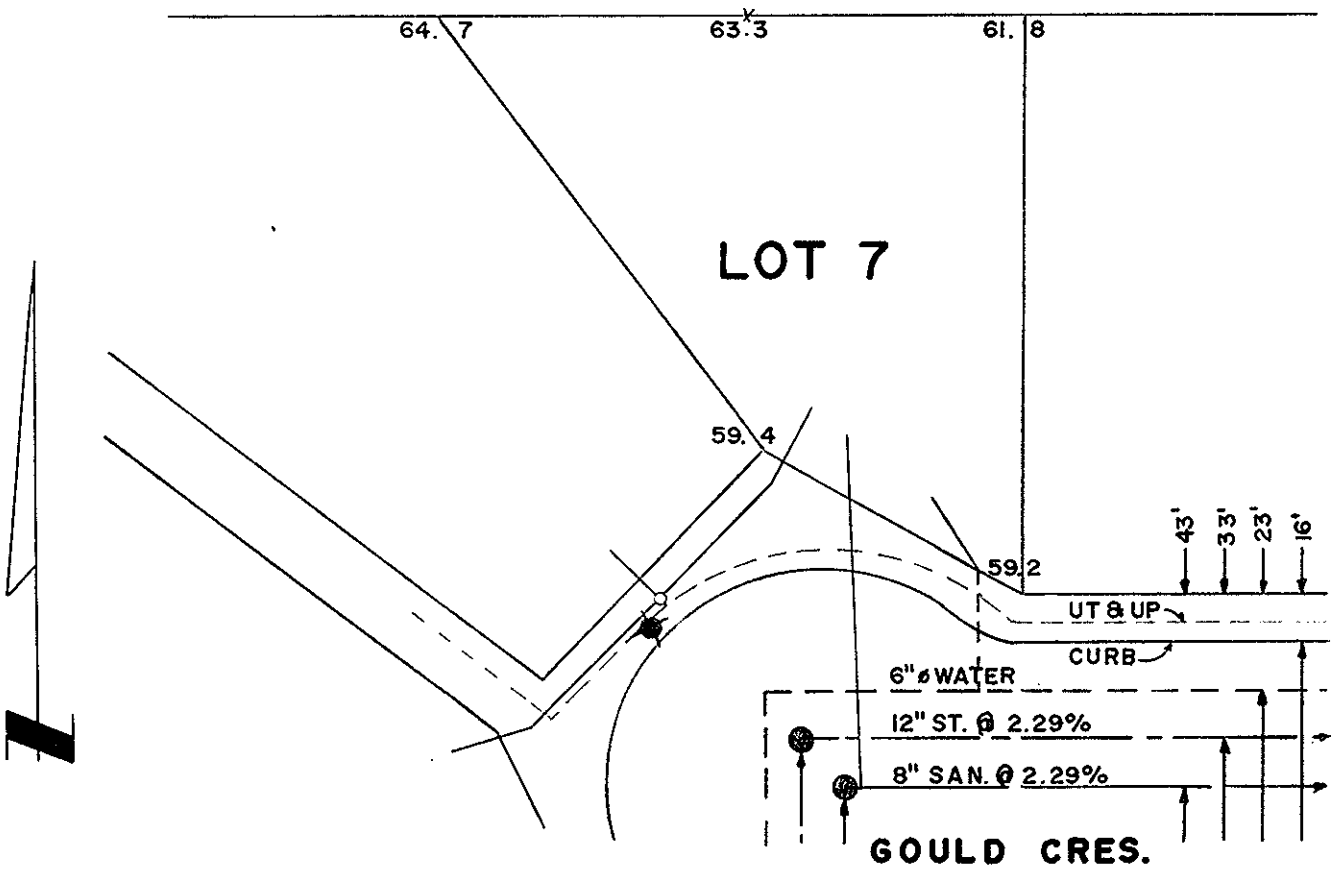
SITE PLAN N.T.S.