021

City of Prince George
HISTORY SHEET

SHEET NUMBER **Roll Number**

Legal: LOT'S 11-12 BLOCK 55 D.L. 936 PLAN 696

Address: 1305 Johnson St.

Sanitary Connection: # 4474 SIZE 100 mm MATERIAL ACS INV. CONNECTED

Water Connection # 4745 SIZE 20 mm MATERIAL Cu METER CONNECTED

Storm Connection: # SIZE MATERIAL INV. CONNECTED

Cash Receipt No's: WATER SANITARY STORM

CURB FROM PROPERTY LINE 5m PAVEMENT WIDTH

B.C. HYDRO UNDERGROUND CONNECTION

B.C. TELEPHONE UNDERGROUND CONNECTION

INLAND GAS ✓

Information Sheets: RP 35, Eng 43 No. 26661

Comments:
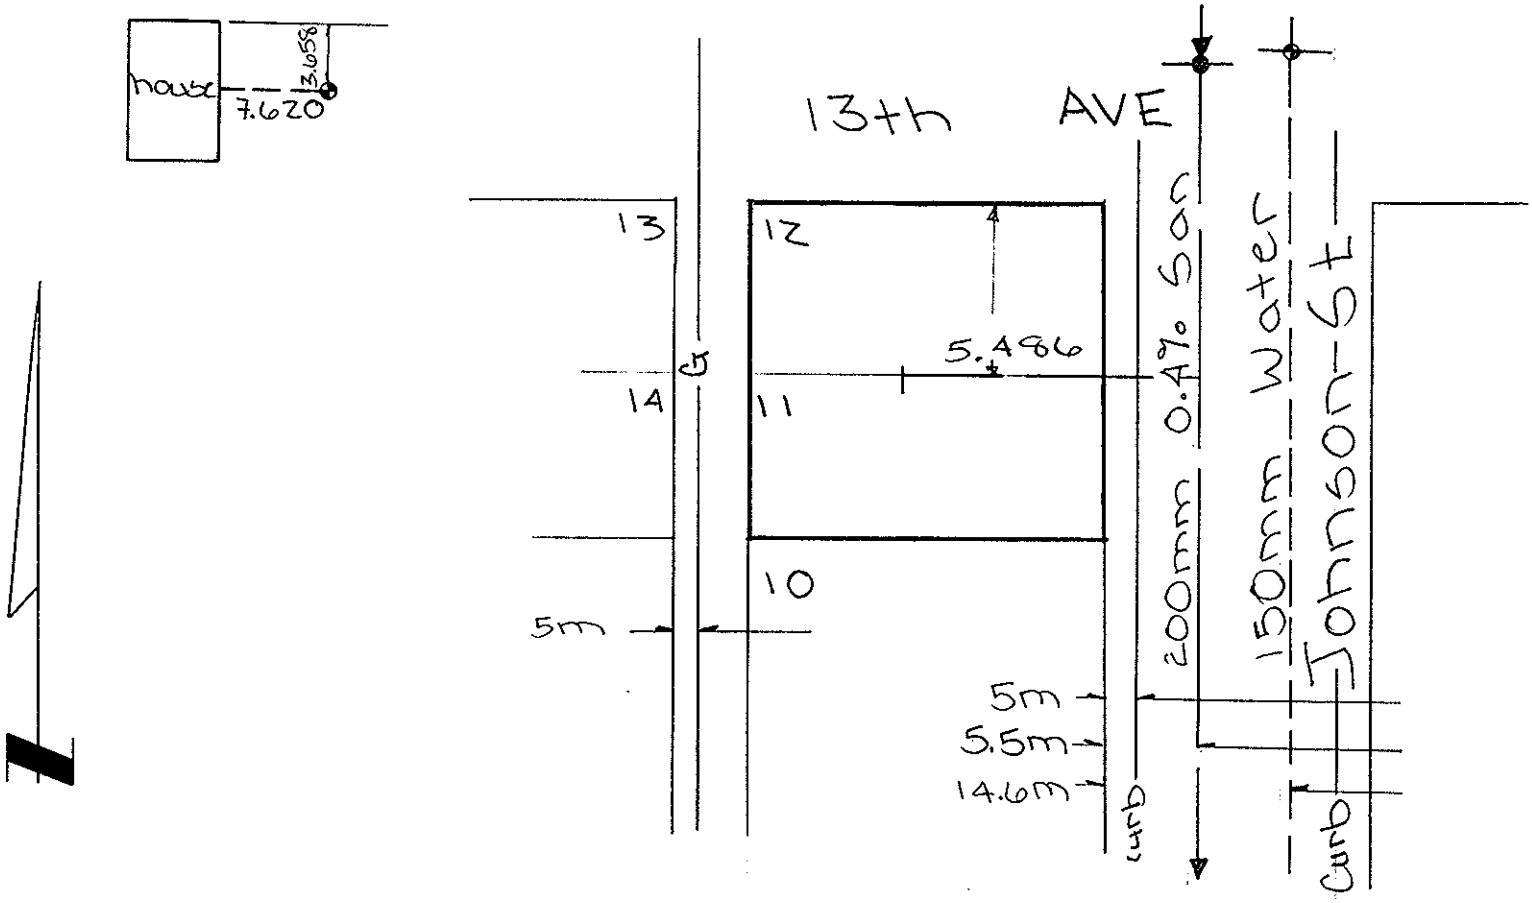
SITE PLAN N.T.S.