City of Prince George
HISTORY SHEET

SHEET NUMBER **4601** **Roll Number** 008511781

Legal: LOT'S 6 BLOCK ——— D.L. 2611 PLAN 23475

Address: 2565 COYLE ST.

Sanitary Connection: # 11155 SIZE 4" MATERIAL A.C. INV. 60.73 CONNECTED

Water Connection # 11155 SIZE 3/4" MATERIAL Cu. METER None CONNECTED

Storm Connection: # SIZE MATERIAL INV. CONNECTED

Cash Receipt No's: WATER SANITARY STORM

CURB FROM PROPERTY LINE 16' (ROLL CURB) PAVEMENT WIDTH 34'

B.C. HYDRO UNDERGROUND CONNECTION

B.C. TELEPHONE UNDERGROUND CONNECTION

INLAND GAS

Information Sheets:

Comments: BENCH MARK # 1413-77 ELEV = 1976.64

H.S.N.E CORNER COYLE & DOCKNICK

LEVEL BOOK - # 333
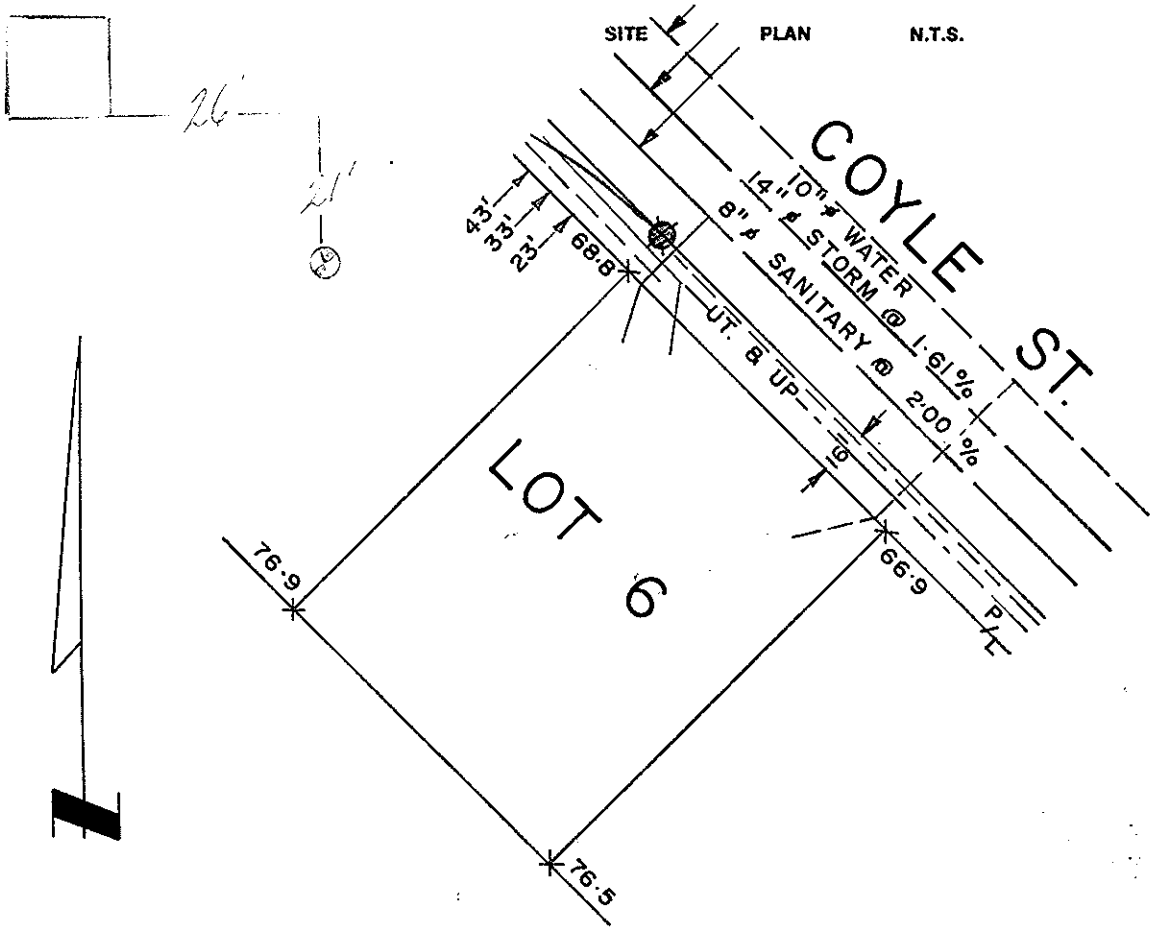
SITE PLAN N.T.S.