City of Prince George
HISTORY SHEET

PREPARED BY K.A.

SHEET NUMBER **4637** Roll Number 00851296S

Legal: LOT'S 42 BLOCK ——— D.L. 2611 PLAN 23475

Address: 3727 FOREST AVENUE

Sanitary Connection: # 11191 SIZE 4" ϕ MATERIAL A.C. INV. 62.04 CONNECTED

Water Connection # 11191 SIZE 3/4" ϕ MATERIAL Cu. METER None CONNECTED

Storm Connection: # SIZE MATERIAL INV. CONNECTED

Cash Receipt No's: WATER SANITARY STORM

CURB FROM PROPERTY LINE 16' (ROLL CURB) = 4.877 m PAVEMENT WIDTH 34' = 10.363 m

B.C. HYDRO U/G AS SHOWN UNDERGROUND CONNECTION U/G

B.C. TELEPHONE U/G AS SHOWN UNDERGROUND CONNECTION U/G

INLAND GAS 12' OFFSET = 3.658M IN FRONT OF PROPERTY

Information Sheets:

Comments: BENCH MARK # 1415-77 ELEVATION = 1965.95

H.S.S.E. CORNER FOREST & COYLE

LEVEL BOOK # 333
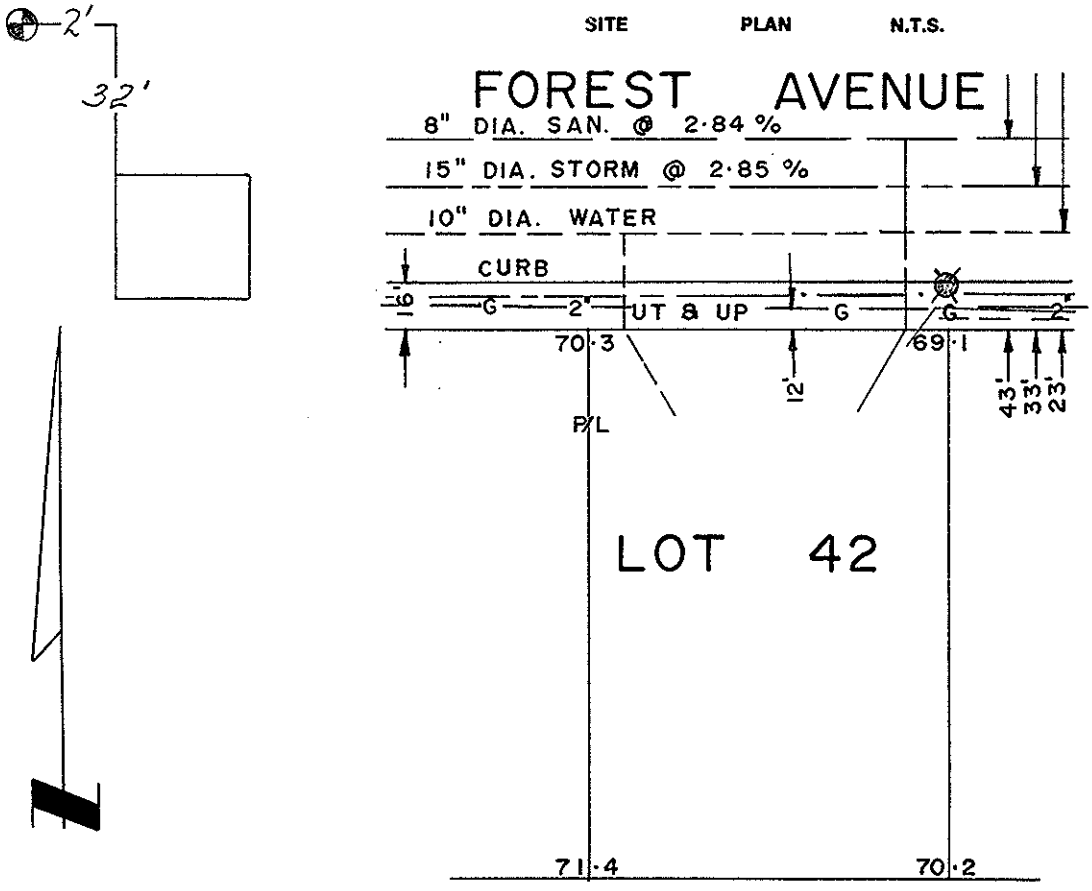
SITE PLAN N.T.S.