City of Prince George
HISTORY SHEET

538 S
490

SHEET NUMBER | **Roll Number**

Legal: LOT'S 11-12 BLOCK 53 D.L. 936 PLAN 696

Address: 1109 Johnson St.

Sanitary Connection: # 1876 SIZE MATERIAL INV. CONNECTED

Water Connection # 3085 SIZE 20 mm MATERIAL METER CONNECTED

Storm Connection: # SIZE MATERIAL INV. CONNECTED

Cash Receipt No's: WATER SANITARY STORM

CURB FROM PROPERTY LINE 5m PAVEMENT WIDTH

B.C. HYDRO UNDERGROUND CONNECTION

B.C. TELEPHONE UNDERGROUND CONNECTION

INLAND GAS ✓

Information Sheets: RP 35 + Eng Form 43 No. 233

Comments:
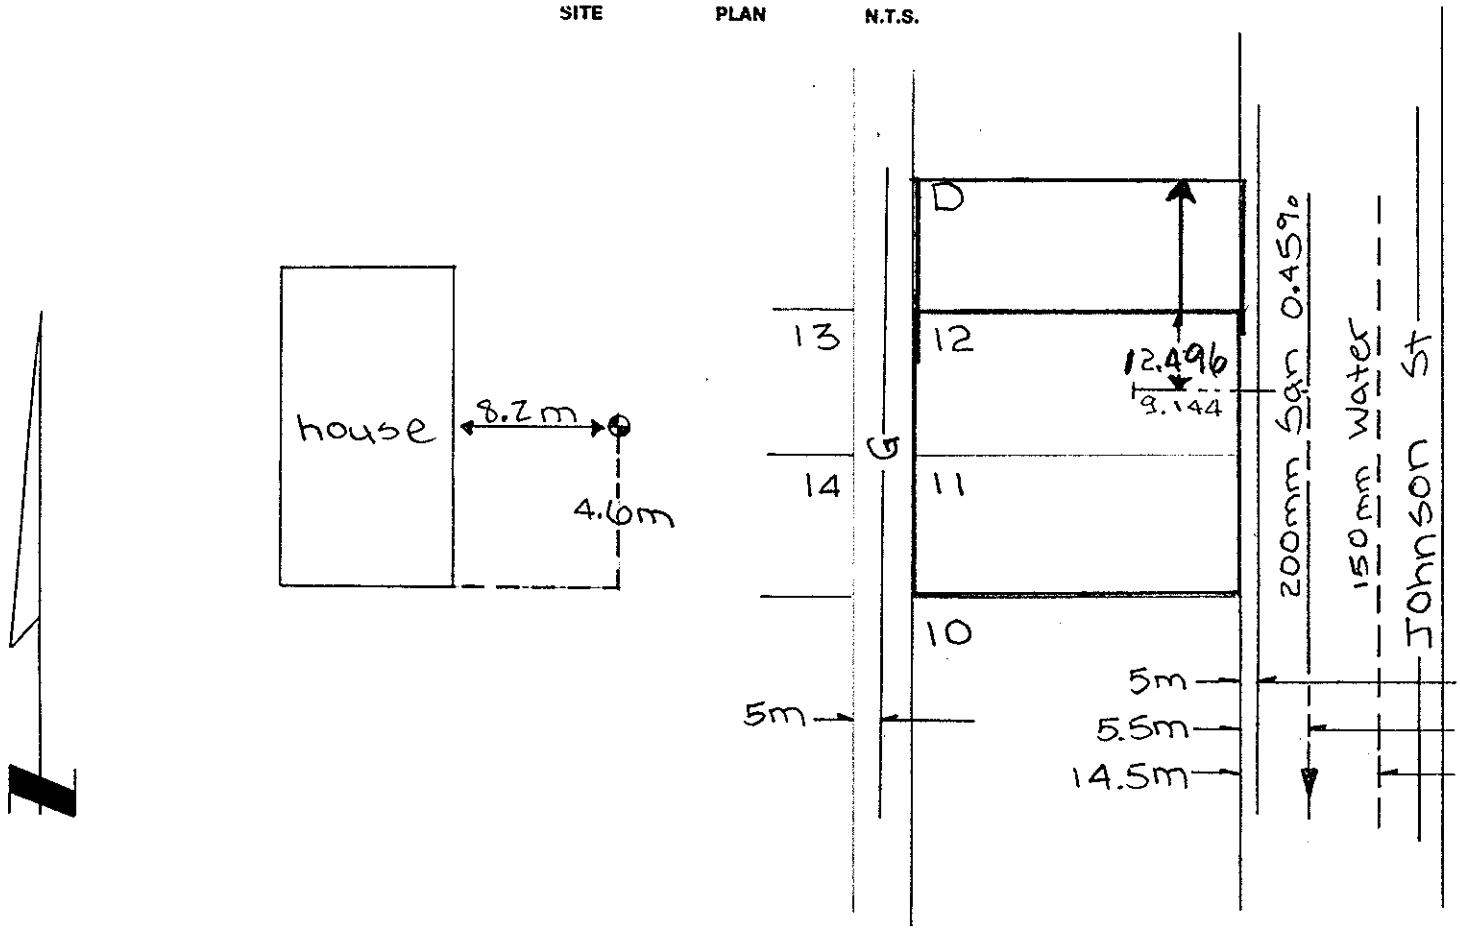
SITE PLAN N.T.S.