City of Prince George
HISTORY SHEET

0085471/3

SHEET NUMBER 7600 Roll Number

Legal: LOT'S 2 BLOCK D.L. 4039 PLAN 14333

Address: 2824 MINNOTTI DR.

Sanitary Connection: # 16035 SIZE 100 mm MATERIAL PVC INV. CONNECTED

Water Connection # 16035 SIZE 20 mm MATERIAL METER CONNECTED

Storm Connection: # SIZE MATERIAL INV. CONNECTED

Cash Receipt No's: WATER 1163 SANITARY 1249 STORM

CURB FROM PROPERTY LINE PAVEMENT WIDTH

B.C. HYDRO O/H UNDERGROUND CONNECTION

B.C. TELEPHONE O/H UNDERGROUND CONNECTION

INLAND GAS AS SHOWN

Information Sheets:

Comments: THE INFORMATION CONTAINED HEREIN IS FOR INTERNAL USE ONLY. NOT TO BE RELIED UPON UNLESS CONFIRMED BY SITE INSPECTION AND/OR INVESTIGATION.
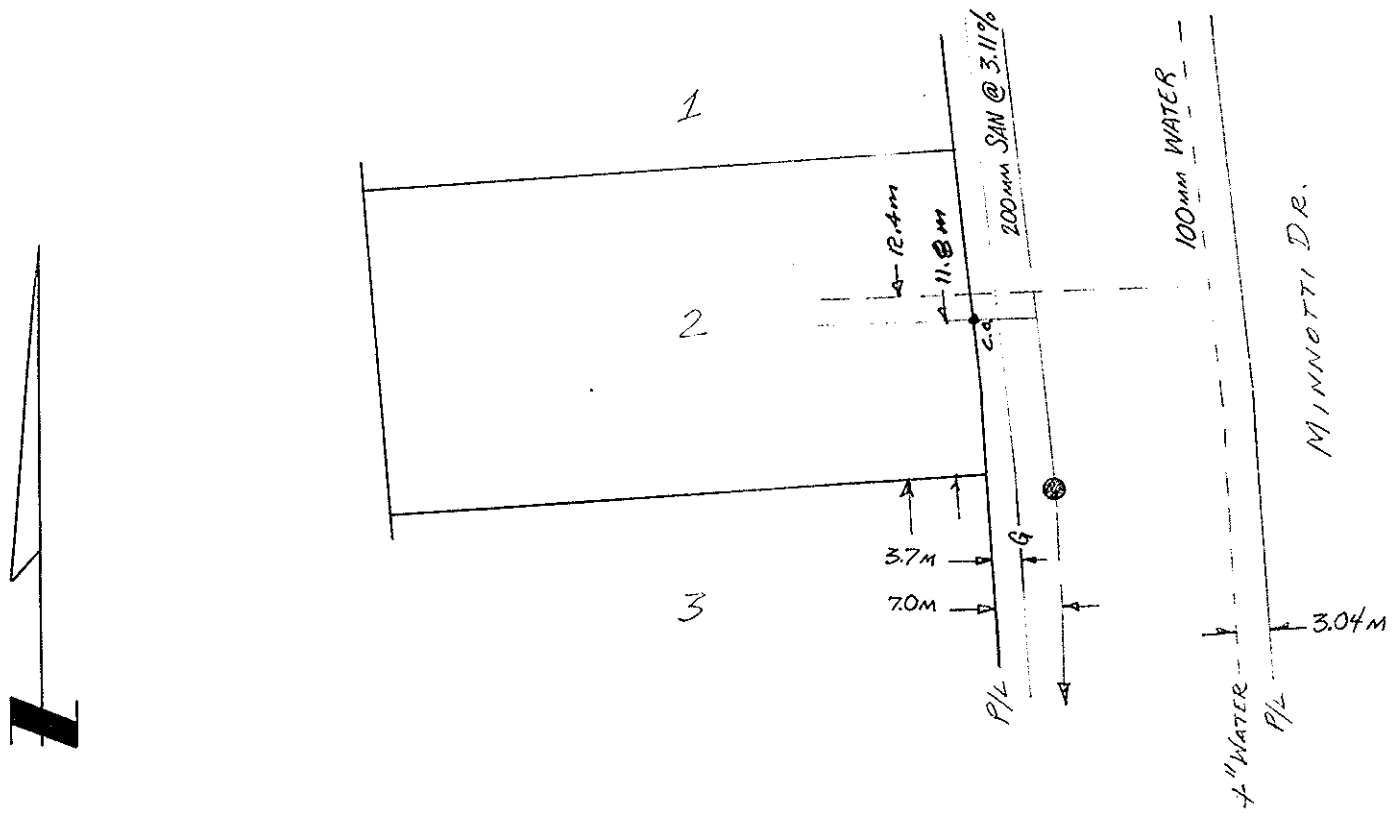
SITE PLAN N.T.S.