City of Prince George
HISTORY SHEET

SHEET NUMBER **Roll Number** 008576017

Legal: LOT'S 35 BLOCK D.L. 754 PLAN 23167

Address: 7134 GUELPH CRES

Sanitary Connection: # SIZE 4" ø MATERIAL P.V.C INV. CONNECTED

Water Connection # SIZE 3/4 ø MATERIAL METER CONNECTED

Storm Connection: # SIZE MATERIAL INV. CONNECTED

Cash Receipt No's: WATER SANITARY STORM

CURB FROM PROPERTY LINE 16 PAVEMENT WIDTH

B.C. HYDRO 3 UNDERGROUND CONNECTION

B.C. TELEPHONE 3 UNDERGROUND CONNECTION

INLAND GAS 56

Information Sheets:
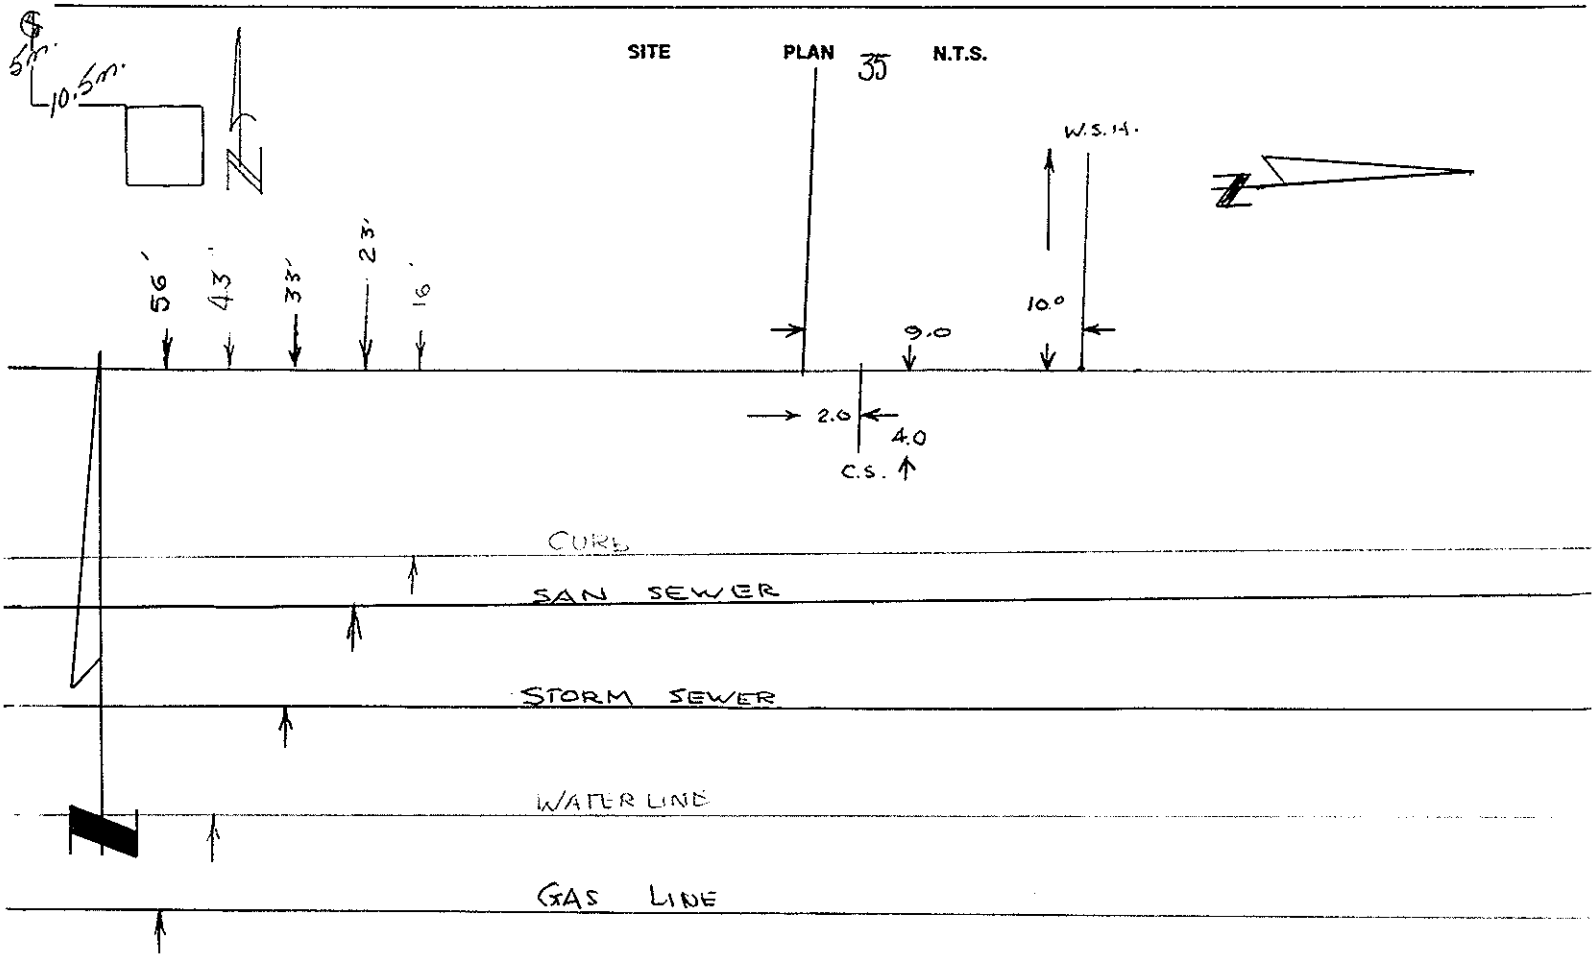
Comments: 66' R/W