City of Prince George
HISTORY SHEET

SHEET NUMBER | **Roll Number**

Legal: LOT'S 29 BLOCK D.L. 2013 PLAN 23118

Address: 8141 ROCHESTER CRES

Sanitary Connection: # SIZE 100mm MATERIAL PVC (WHITE) INV. CONNECTED

Water Connection # SIZE 20mm MATERIAL Cu METER CONNECTED

Storm Connection: # SIZE 100mm MATERIAL PVC (GREEN) INV. CONNECTED

Cash Receipt No's: WATER SANITARY STORM

CURB FROM PROPERTY LINE 4.877 m PAVEMENT WIDTH 10.363 m

B.C. HYDRO 0.914 m UNDERGROUND CONNECTION ✓

B.C. TELEPHONE 0.914 m UNDERGROUND CONNECTION ✓

INLAND GAS 3.048 m

Information Sheets:

Comments: 66' R/W = 20.116 m REDRAWN FROM ORIGINAL CONTRACT H.S. 58
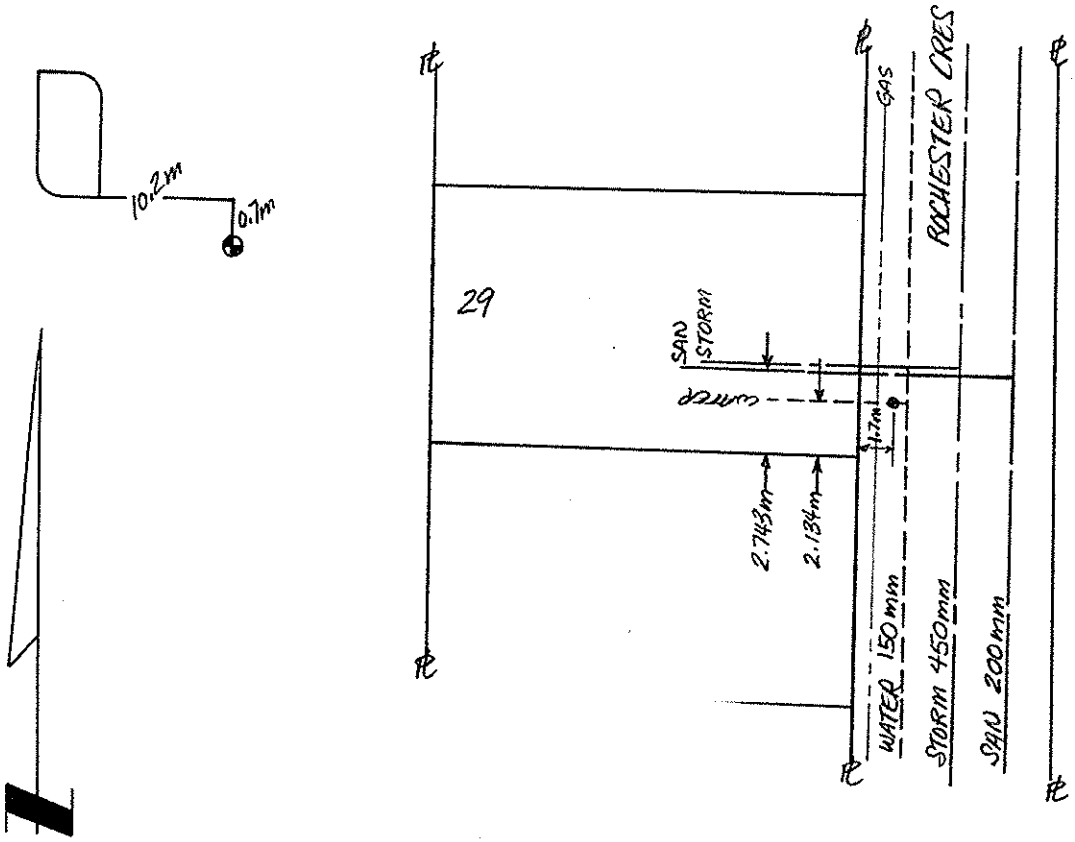
THE INFORMATION CONTAINED HEREIN IS FOR INTERNAL USE ONLY.
NOT TO BE RELIED UPON UNLESS CONFIRMED BY SITE INSPECTION AND/OR INVESTIGATION