City of Prince George
HISTORY SHEET

SHEET NUMBER 8593 **Roll Number**

Legal: LOT'S 80 BLOCK D.L. 2013 PLAN 23118

Address: 8048 PRINCETON CRES

Sanitary Connection: # SIZE 4" MATERIAL WE P.V.C. INV. CONNECTED

Water Connection # SIZE 3/4" MATERIAL COPPER METER CONNECTED

Storm Connection: # SIZE 4" MATERIAL CR P.V.C. INV. CONNECTED

Cash Receipt No's: WATER SANITARY STORM

CURB FROM PROPERTY LINE 15' PAVEMENT WIDTH 34'

B.C. HYDRO 3' UNDERGROUND CONNECTION ✓

B.C. TELEPHONE 3' UNDERGROUND CONNECTION ✓

INLAND GAS 8'

Information Sheets:
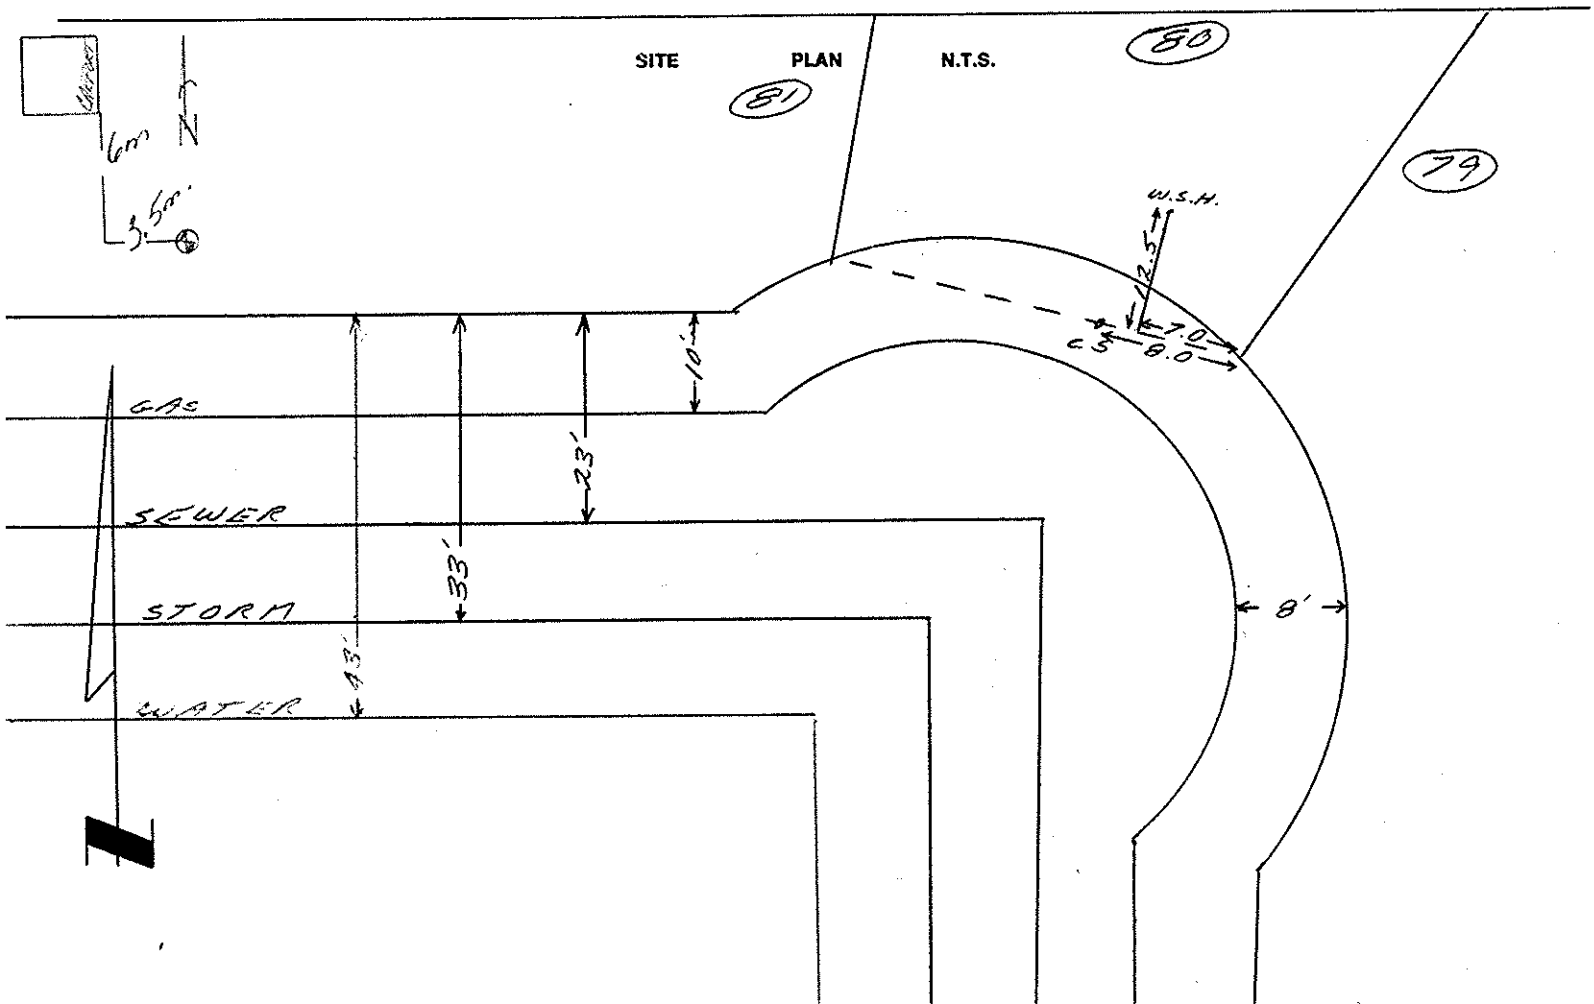
Comments: 66' R/W