City of Prince George
HISTORY SHEET

SHEET NUMBER 8427 Roll Number

Legal: LOT'S 70 BLOCK D.L. 2013 PLAN 23008

Address: 8022 NEWCASTLE CRES.

Sanitary Connection: # SIZE 4" WHITE MATERIAL P.V.C. INV. CONNECTED

Water Connection # SIZE 3/4" MATERIAL COPPER METER CONNECTED

Storm Connection: # SIZE 4" GREEN MATERIAL P.V.C. INV. CONNECTED

Cash Receipt No's: WATER SANITARY STORM

CURB FROM PROPERTY LINE 16' PAVEMENT WIDTH 34'

B.C. HYDRO 3' UNDERGROUND CONNECTION ✓

B.C. TELEPHONE 3' UNDERGROUND CONNECTION ✓

INLAND GAS 56'

Information Sheets:

Comments: 66' R/W
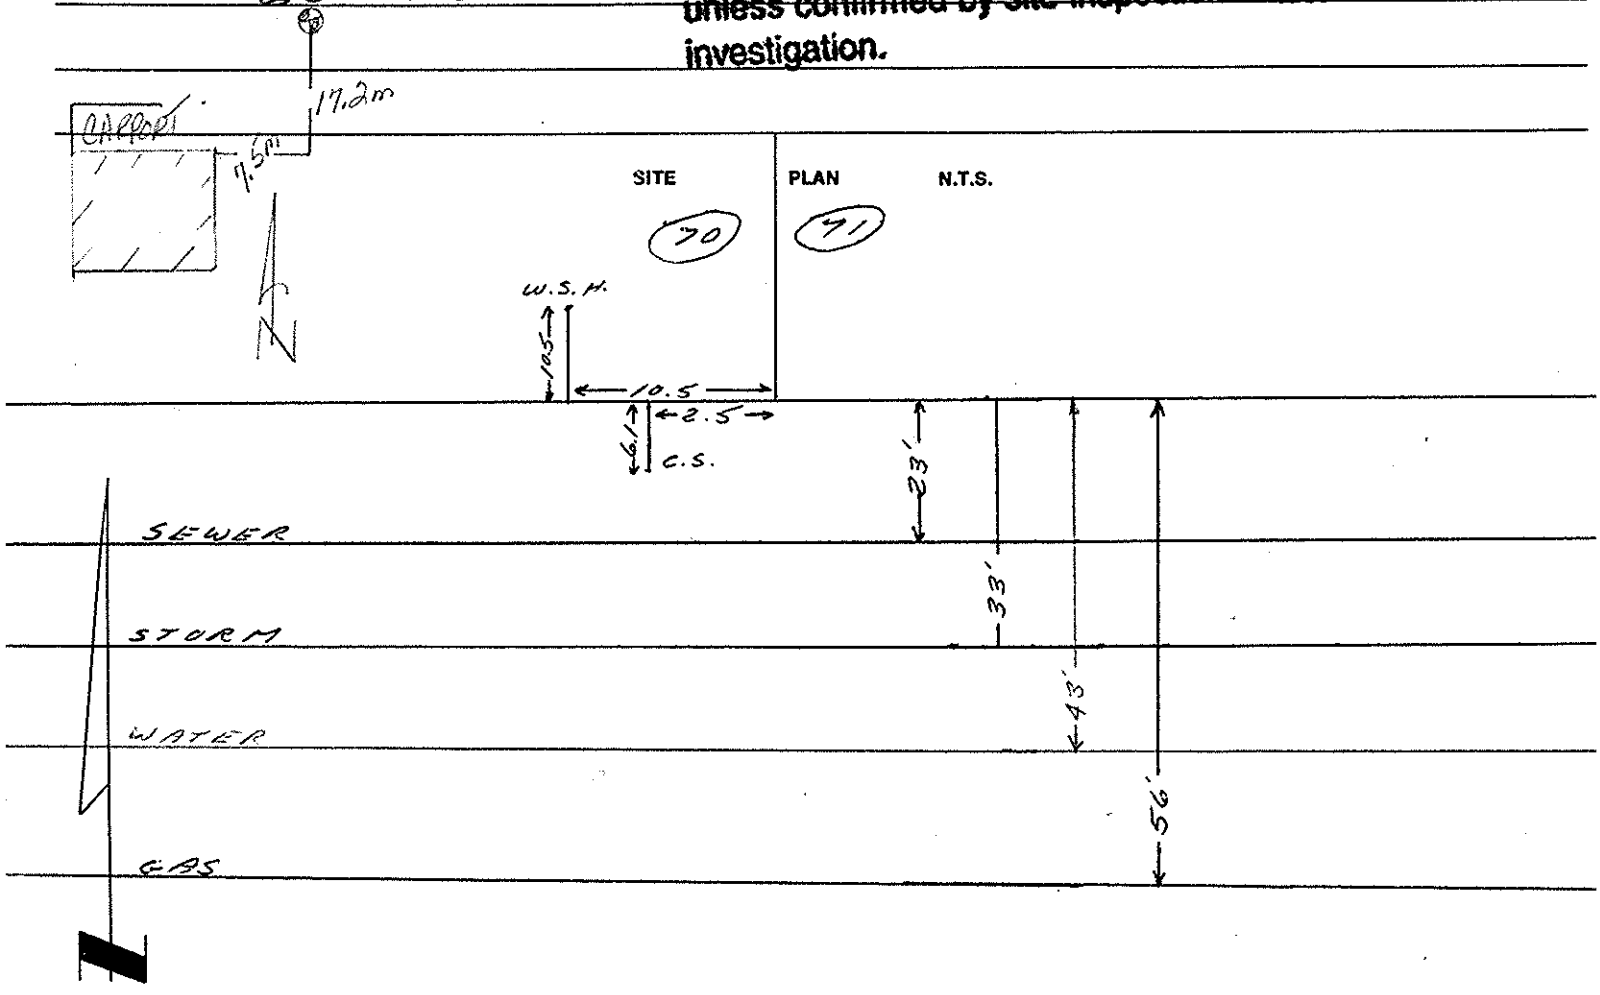
The information contained herein is for internal use only. Not to be relied upon unless confirmed by site inspection and/or investigation.