City of Prince George
HISTORY SHEET

SHEET NUMBER 8623 | Roll Number

Legal: LOT'S 23 | BLOCK | D.L. 2013 | PLAN 23009

Address: 7837 ROCHESTER CRES

Sanitary Connection: # | SIZE 4" | MATERIAL WHITE PVC | INV. | CONNECTED

Water Connection # | SIZE 3/4" | MATERIAL COPPER | METER | CONNECTED

Storm Connection: # | SIZE | MATERIAL | INV. | CONNECTED

Cash Receipt No's: WATER | SANITARY | STORM

CURB FROM PROPERTY LINE 16' | PAVEMENT WIDTH 34'

B.C. HYDRO 3' | UNDERGROUND CONNECTION ✓

B.C. TELEPHONE 3' | UNDERGROUND CONNECTION ✓

INLAND GAS 10'

Information Sheets:

Comments: 66' ~~10~~/W.
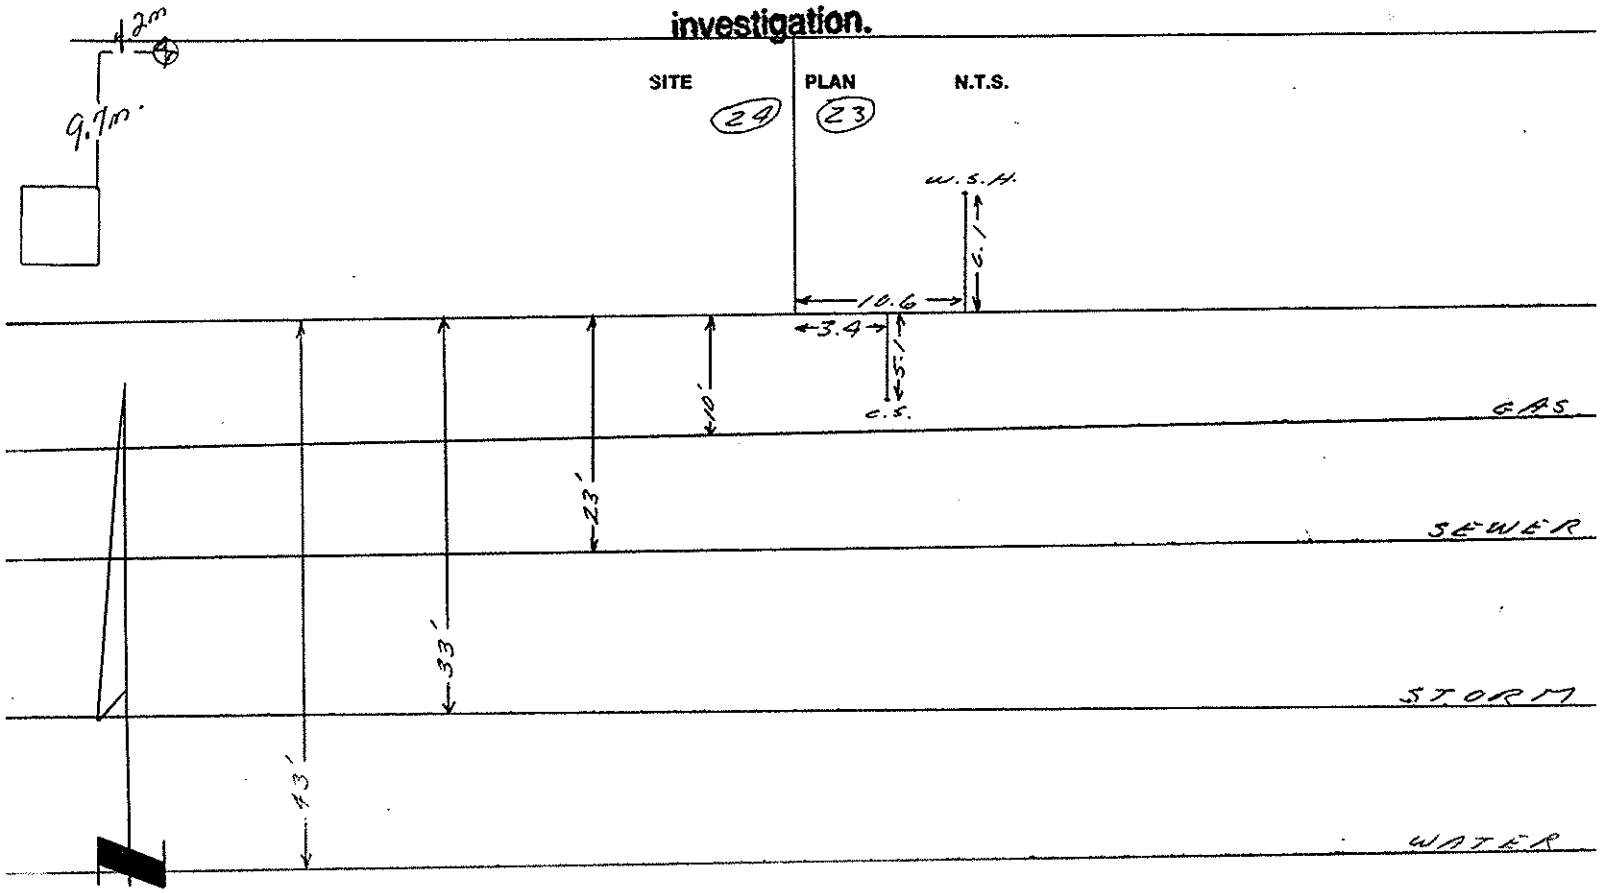
The information contained herein is for internal use only. Not to be relied upon unless confirmed by site inspection and/or investigation.