City of Prince George
HISTORY SHEET

FM

SHEET NUMBER **4428** **Roll Number** 008700737

Legal: LOT'S 56 BLOCK D.L. 482 PLAN 22883

Address: 375 MULLET CRES.

Sanitary Connection: # SIZE 4" MATERIAL A.C INV. 95.40 CONNECTED

Water Connection # SIZE 3/4" MATERIAL CU METER NONE CONNECTED

Storm Connection: # SIZE MATERIAL INV. CONNECTED

Cash Receipt No's: WATER SANITARY STORM

CURB FROM PROPERTY LINE PAVEMENT WIDTH

B.C. HYDRO UNDERGROUND CONNECTION

B.C. TELEPHONE UNDERGROUND CONNECTION

INLAND GAS

Information Sheets:

Comments: BM - S.E. COR N&W LEGS MULLET
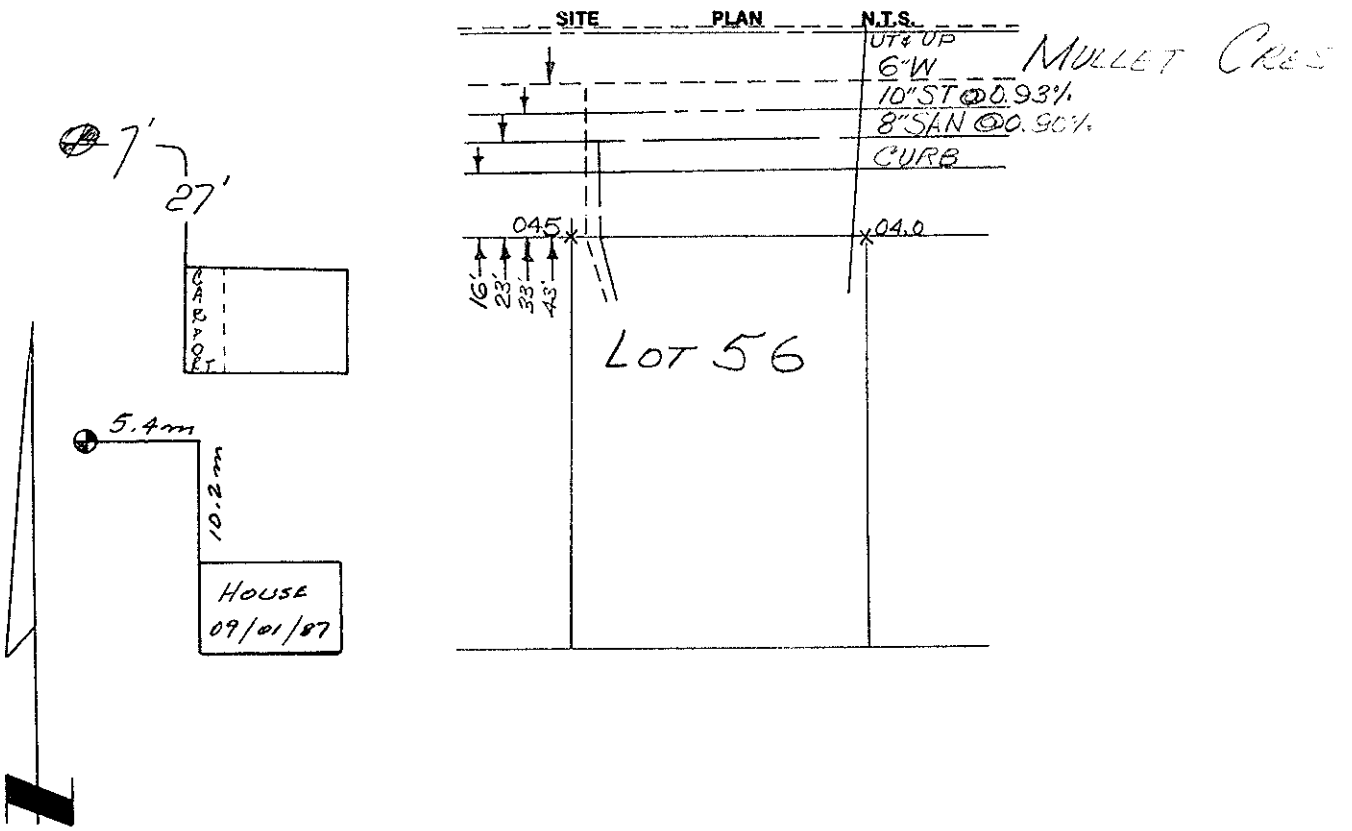
STANDARD CONN OFFSET