City of Prince George
HISTORY SHEET

SHEET NUMBER **4439** **Roll Number** 008700842

Legal: LOT'S 67 BLOCK D.L. 482 PLAN 22883

Address: 366 Killoren Cres.

Sanitary Connection: # SIZE 4" MATERIAL A.C. INV. 90.62 CONNECTED

Water Connection # SIZE 3/4" MATERIAL Cu METER None CONNECTED

Storm Connection: # SIZE MATERIAL INV. CONNECTED

Cash Receipt No's: WATER SANITARY STORM

CURB FROM PROPERTY LINE PAVEMENT WIDTH

B.C. HYDRO UNDERGROUND CONNECTION

B.C. TELEPHONE UNDERGROUND CONNECTION

INLAND GAS

Information Sheets:

Comments: BM-200389 NE COR. ELEG KILLOREN & NLEG MUNDET
STANDARD CONN. OFFSET
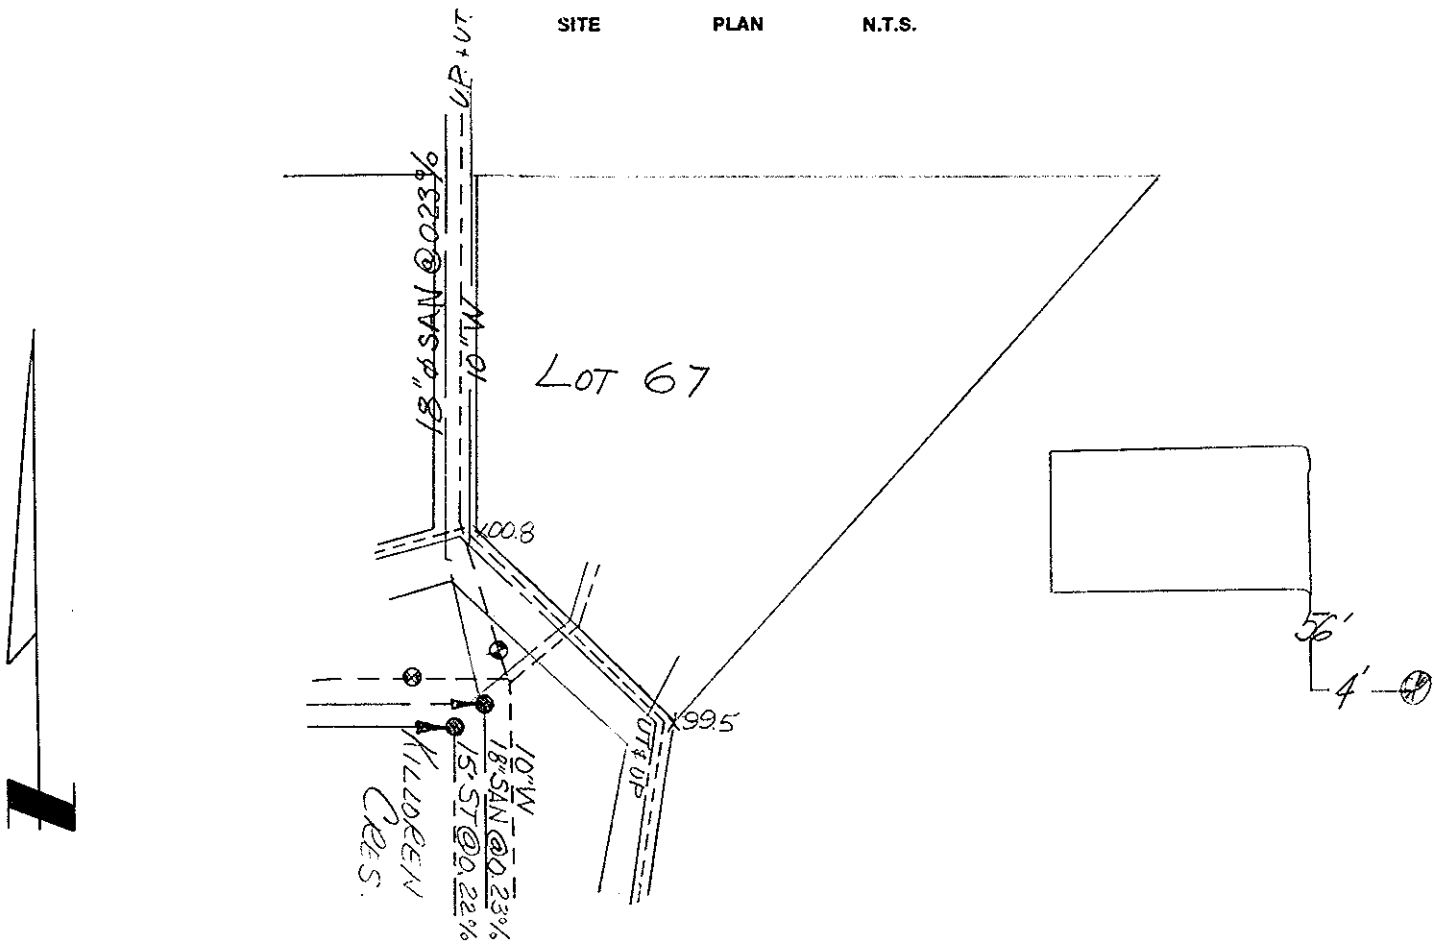
SITE PLAN N.T.S.