City of Prince George
HISTORY SHEET

SHEET NUMBER 2303 **Roll Number** 008721/645

Legal: LOT'S 6 BLOCK D.L. 754. PLAN ~~20248~~ 22835

Address: 6240 TRENT DRIVE

Sanitary Connection: # SIZE 4" MATERIAL P.V.C. INV. CONNECTED

Water Connection # SIZE 3/4" MATERIAL COPPER METER CONNECTED

Storm Connection: # SIZE MATERIAL INV. CONNECTED

Cash Receipt No's: WATER SANITARY STORM

CURB FROM PROPERTY LINE 18' PAVEMENT WIDTH 34'

B.C. HYDRO UNDERGROUND CONNECTION

B.C. TELEPHONE UNDERGROUND CONNECTION

INLAND GAS

Information Sheets:

Comments:

HYDRANT N.W. TRENT & CALEDONIA CRES ELEV = 2014.05
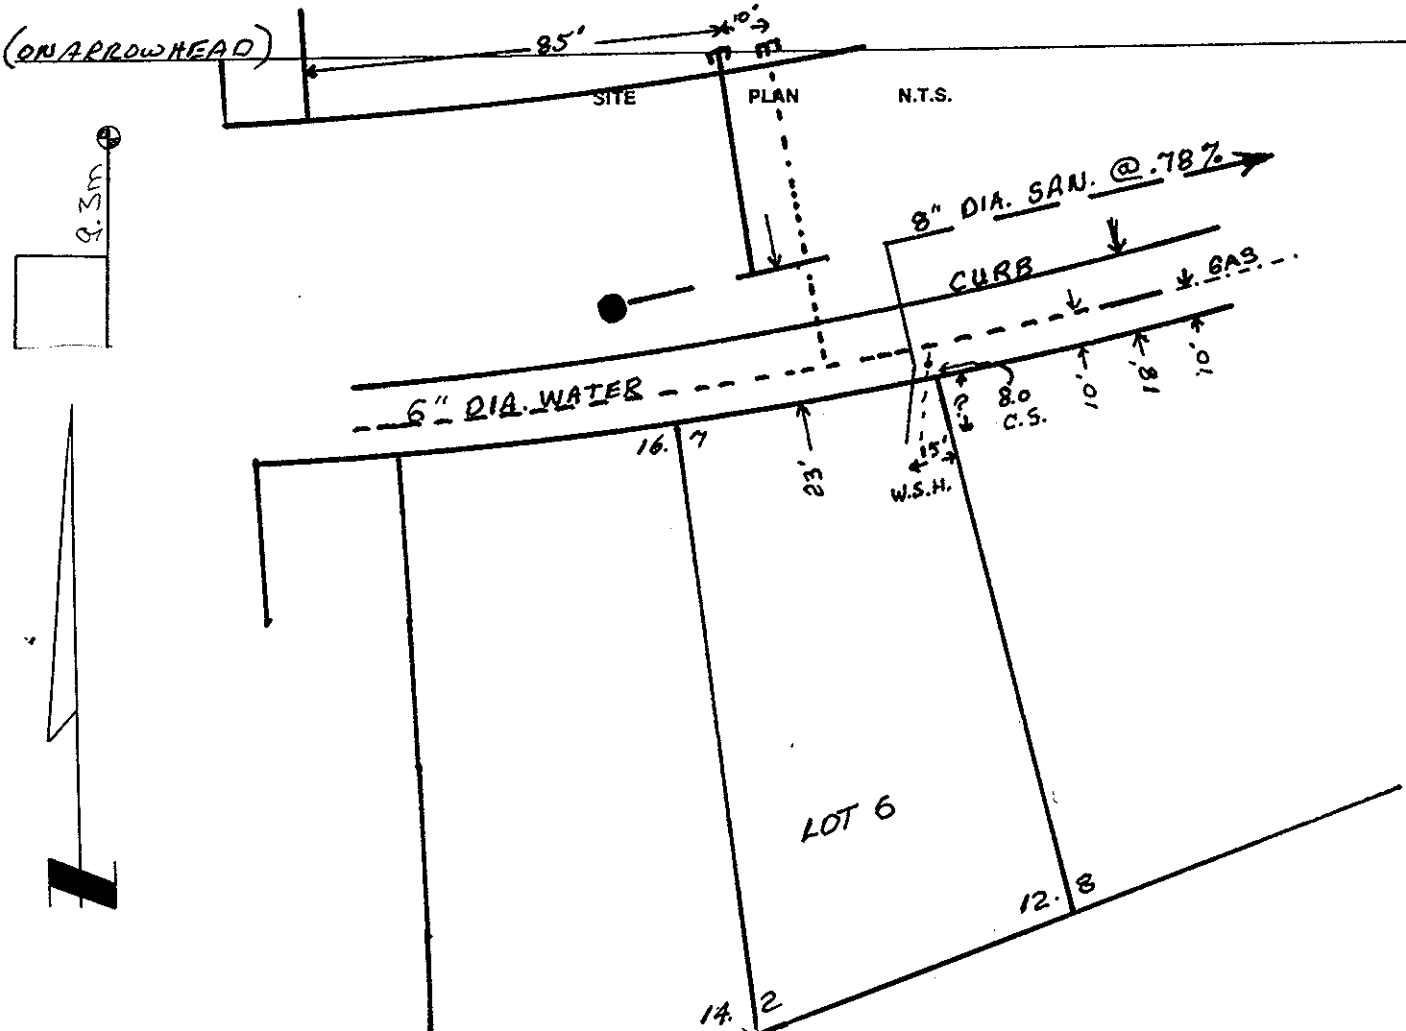
(ON ARROWHEAD)