City of Prince George
HISTORY SHEET

SHEET NUMBER **Roll Number** 008732001

Legal: LOT'S 66 BLOCK D.L. 2507 PLAN 22809

Address: 4526 AZURE AVE

Sanitary Connection: # 10822 SIZE 4"ϕ MATERIAL AC. INV. 97.20 CONNECTED

Water Connection # 10822 SIZE 3/4 ϕ MATERIAL Cu. METER CONNECTED

Storm Connection: # SIZE 4"ϕ MATERIAL AC INV. 96.71 CONNECTED

Cash Receipt No's: WATER SANITARY STORM

CURB FROM PROPERTY LINE 16' PAVEMENT WIDTH 34'

B.C. HYDRO UNDERGROUND CONNECTION

B.C. TELEPHONE UNDERGROUND CONNECTION

INLAND GAS

Information Sheets:

Comments: B.M. H.S. N.E. CORNER AZURE & EAST ELKHORN

DRAINAGE SWALE TO BE MAINTAINED

LEVEL BOOK - 333
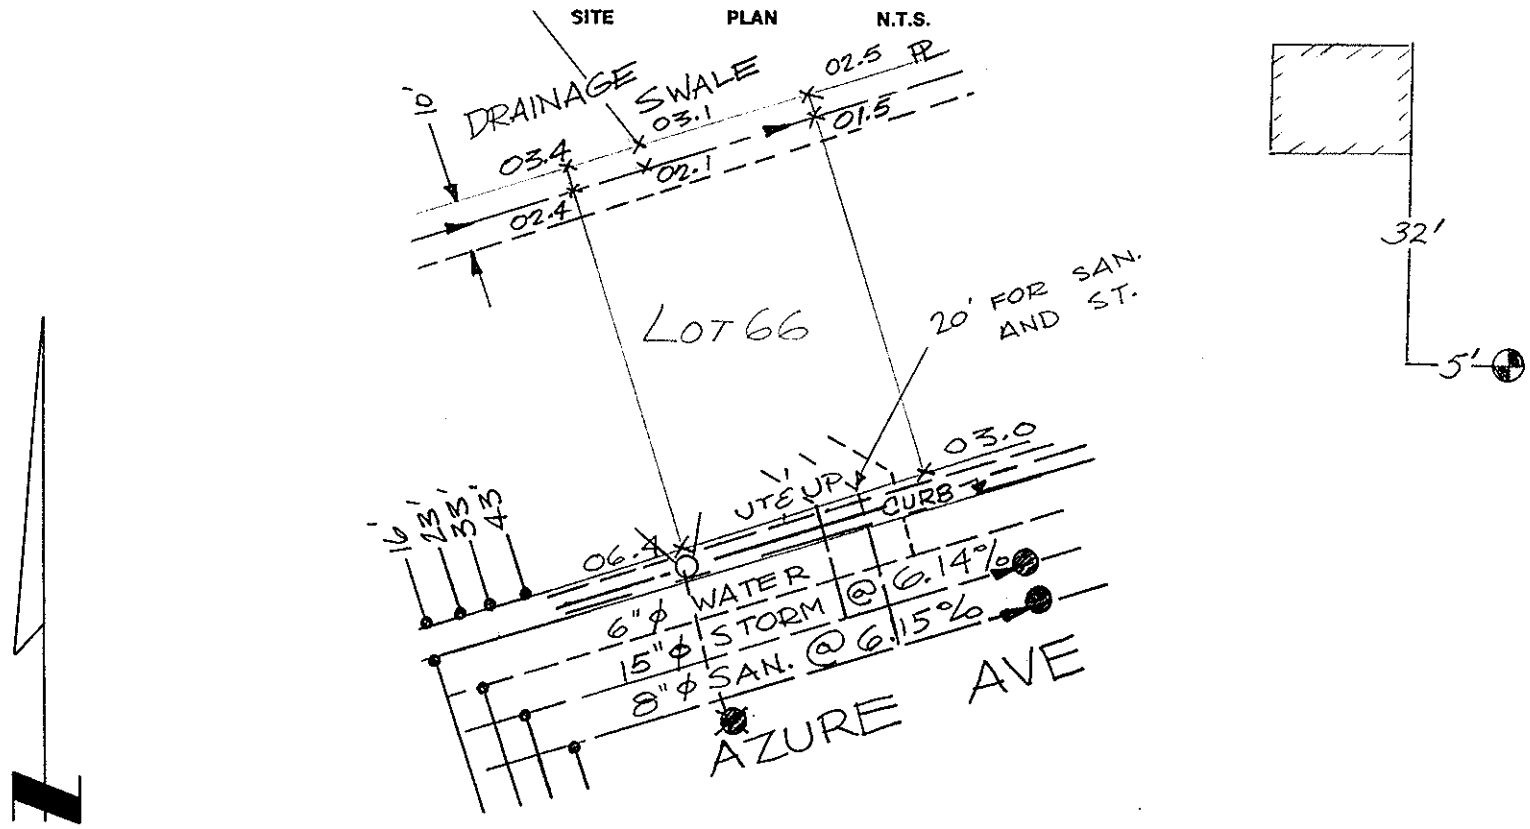
SITE PLAN N.T.S.