City of Prince George
HISTORY SHEET

0089897

SHEET NUMBER 4356 **Roll Number**

Legal: LOT'S 19 BLOCK D.L. 482 PLAN 22721

Address: 4843 Zimmaro Ave.

Sanitary Connection: # SIZE 4" MATERIAL A.C. INV. 03.38 CONNECTED YES

Water Connection # SIZE 3/4" MATERIAL Co METER No CONNECTED YES

Storm Connection: # SIZE MATERIAL INV. CONNECTED

Cash Receipt No's: WATER SANITARY STORM

CURB FROM PROPERTY LINE PAVEMENT WIDTH

B.C. HYDRO UNDERGROUND CONNECTION

B.C. TELEPHONE UNDERGROUND CONNECTION

INLAND GAS

Information Sheets:

Comments: B.M. No. 1303-76
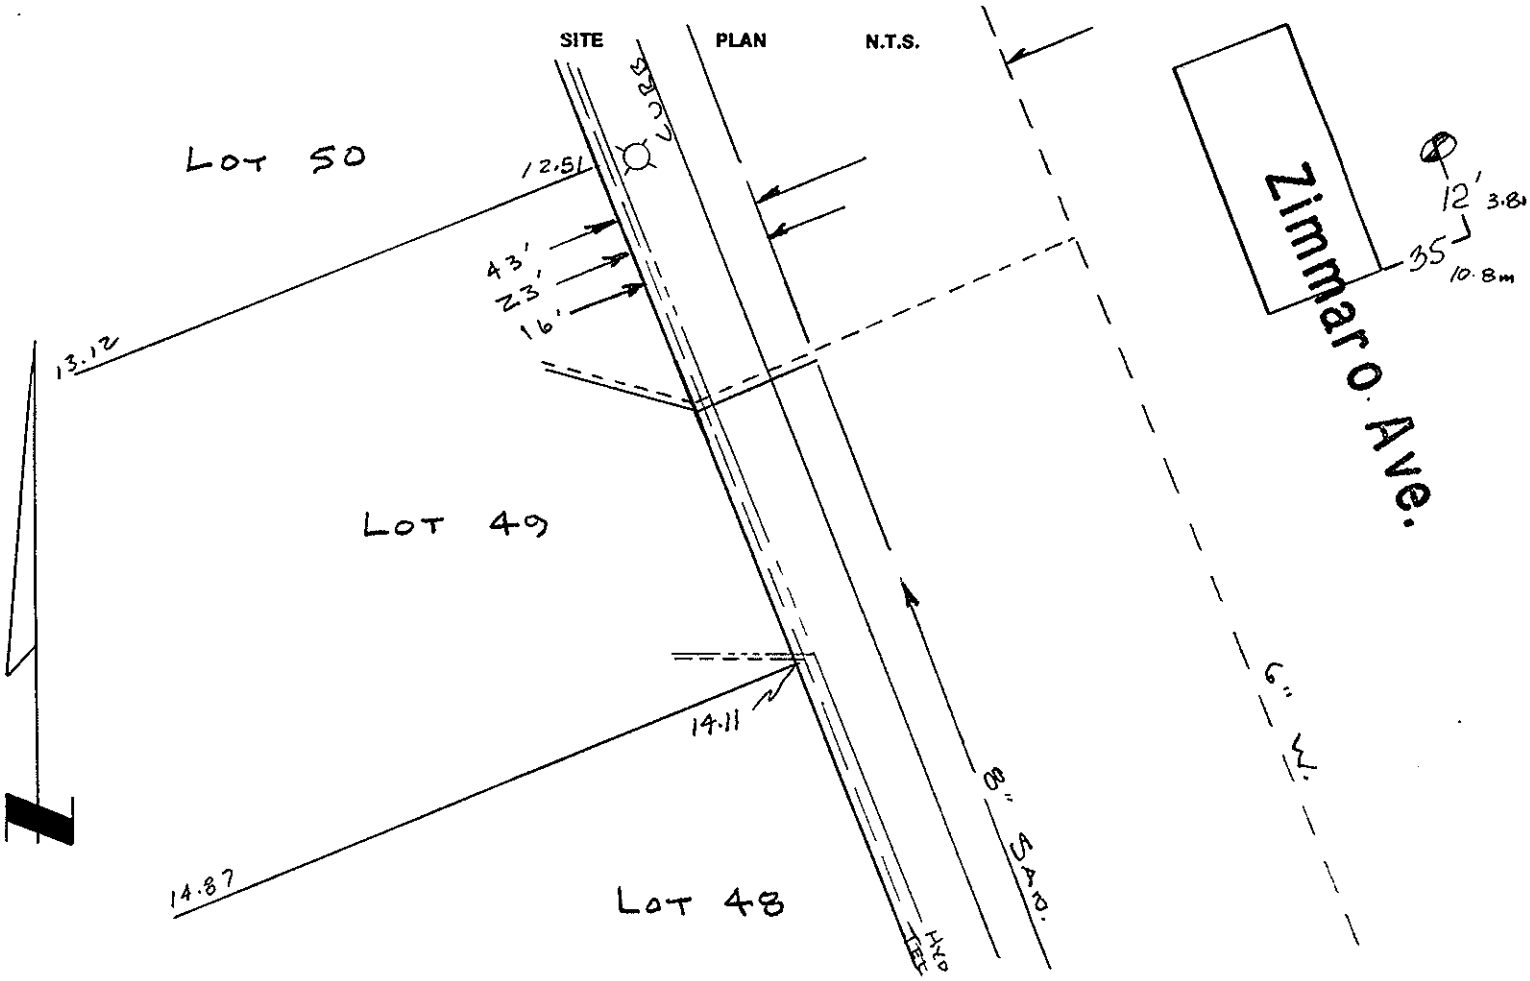
H.S. N.W. Cor. Zimmaro & Wood Place. Elev. 2017.47