City of Prince George
HISTORY SHEET

SHEET NUMBER **Roll Number** 08-79-26

Legal: LOT'S 7 BLOCK D.L. 2609 PLAN 22809

Address: 1343 ELKHORN CRES

Sanitary Connection: # 10763 SIZE 4" ϕ MATERIAL AC. INV. 13.69 CONNECTED

Water Connection # 10763 SIZE 3/4" ϕ MATERIAL Cu. METER CONNECTED

Storm Connection: # SIZE 4" ϕ MATERIAL AC. INV. 13.71 CONNECTED

Cash Receipt No's: WATER SANITARY STORM

CURB FROM PROPERTY LINE 16' PAVEMENT WIDTH 34'

B.C. HYDRO UNDERGROUND CONNECTION

B.C. TELEPHONE UNDERGROUND CONNECTION

INLAND GAS

Information Sheets:

THE INFORMATION CONTAINED HEREIN IS FOR INTERNAL USE ONLY. NOT TO BE RELIED UPON UNLESS CONFIRMED BY SITE INSPECTION AND/OR INVESTIGATION.

Comments: BENCH MARKS - H.S. ELKHORN CR - OFFSET FROM PL - BETWEEN LOTS 38 & 39

LEVEL BOOK - 333
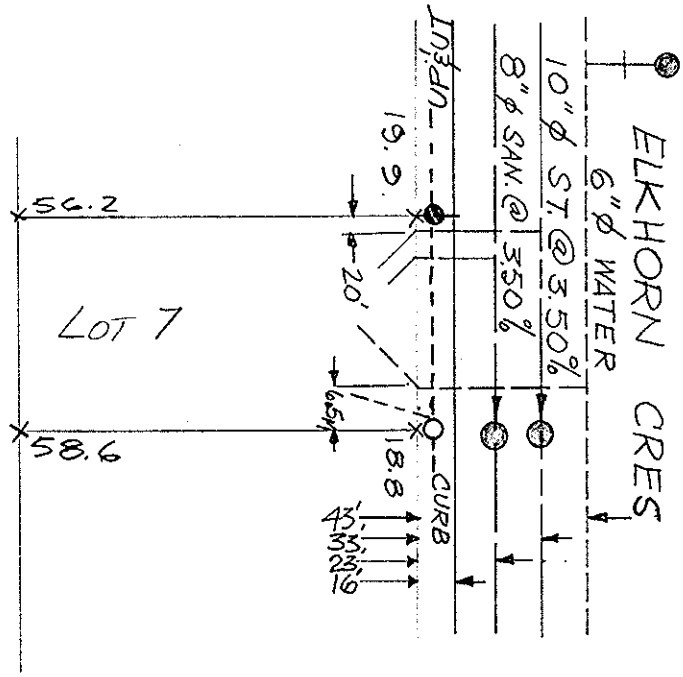
SITE PLAN N.T.S.