City of Prince George
HISTORY SHEET

008795363

SHEET NUMBER 4341 Roll Number

Legal: LOT'S 32 BLOCK D.L. 482 PLAN 22721

Address: 4840 Zimmaro Ave.

Sanitary Connection: # SIZE 4" MATERIAL A.C. INV. 03.21 CONNECTED

Water Connection # SIZE 3/4" MATERIAL Co METER No CONNECTED

Storm Connection: # SIZE MATERIAL INV. CONNECTED

Cash Receipt No's: WATER SANITARY STORM

CURB FROM PROPERTY LINE PAVEMENT WIDTH

B.C. HYDRO UNDERGROUND CONNECTION

B.C. TELEPHONE UNDERGROUND CONNECTION

INLAND GAS

Information Sheets:

Comments: B.M. No. 1304-76.
H.S. N. side Zimmaro ¼ E of Wade. Elev. 2009.76
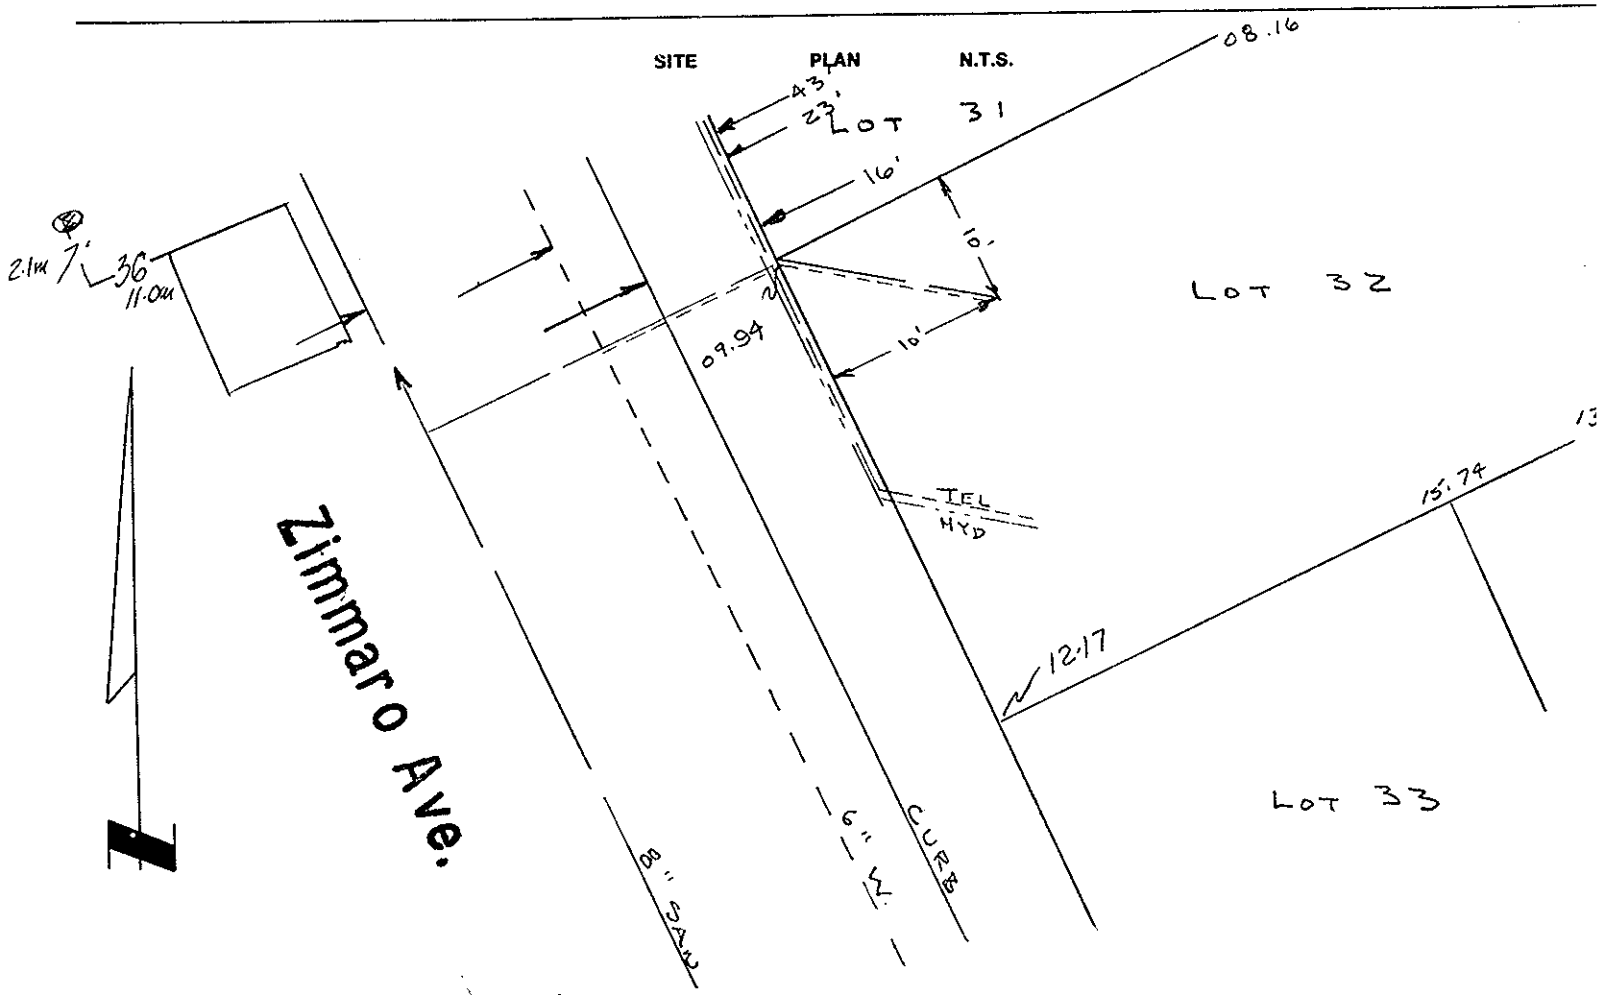
SITE PLAN N.T.S.