City of Prince George
HISTORY SHEET

SHEET NUMBER 2329 Roll Number 608 854 025

Legal: LOT'S 25 BLOCK D.L. 753 PLAN 22603

Address: 5553 MADDEN PLC.

Sanitary Connection: # SIZE 4" MATERIAL A.C. INV. CONNECTED

Water Connection # SIZE 3/4" MATERIAL Cu. METER CONNECTED

Storm Connection: # SIZE MATERIAL INV. CONNECTED

Cash Receipt No's: WATER SANITARY STORM

CURB FROM PROPERTY LINE 16' PAVEMENT WIDTH 34'

B.C. HYDRO 3' UNDERGROUND CONNECTION

B.C. TELEPHONE 3' UNDERGROUND CONNECTION

INLAND GAS 10'

Information Sheets:
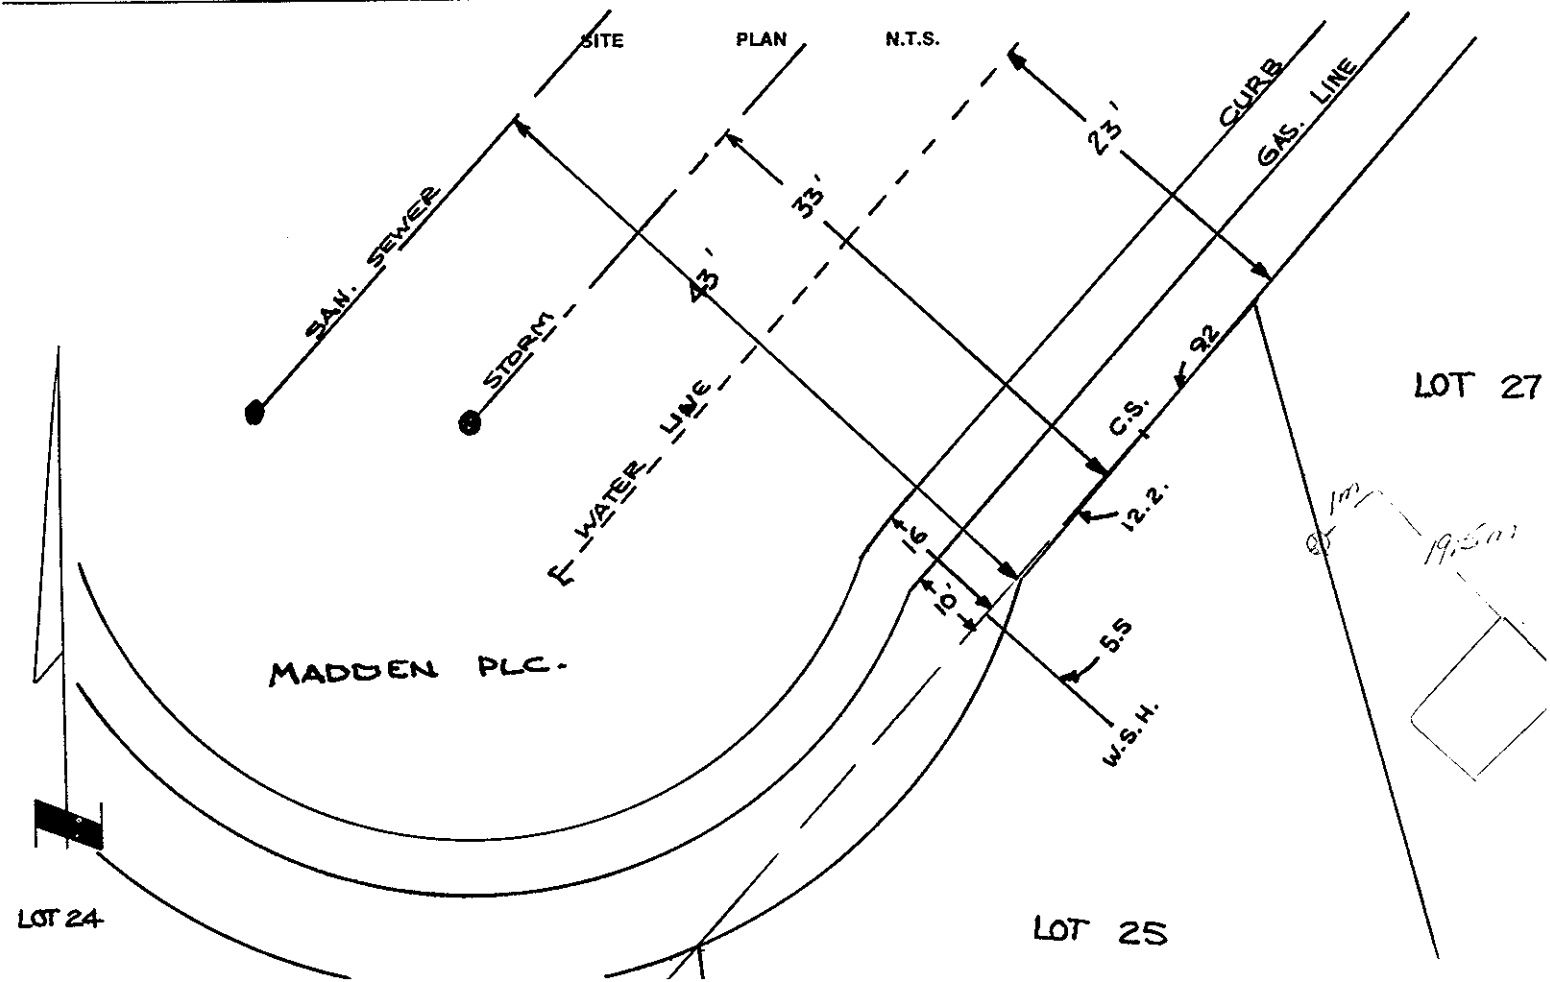
Comments: