City of Prince George
HISTORY SHEET

D S
FL

SHEET NUMBER **Roll Number** 00887/841

Legal: LOT'S 53 BLOCK D.L. 2609 PLAN 32535

Address: 4632 ROBSON AVENUE

Sanitary Connection: # 10750 SIZE 4" MATERIAL A.C. INV. 2010.76 CONNECTED

Water Connection # 10750 SIZE 3/4" MATERIAL COPPER METER NO CONNECTED

Storm Connection: # 653 SIZE 4" MATERIAL A.C. INV. 2012.19 CONNECTED

Cash Receipt No's: WATER SANITARY STORM

CURB FROM PROPERTY LINE 16' PAVEMENT WIDTH 34'

B.C. HYDRO UNDERGROUND CONNECTION

B.C. TELEPHONE UNDERGROUND CONNECTION

INLAND GAS

Information Sheets:

Comments:
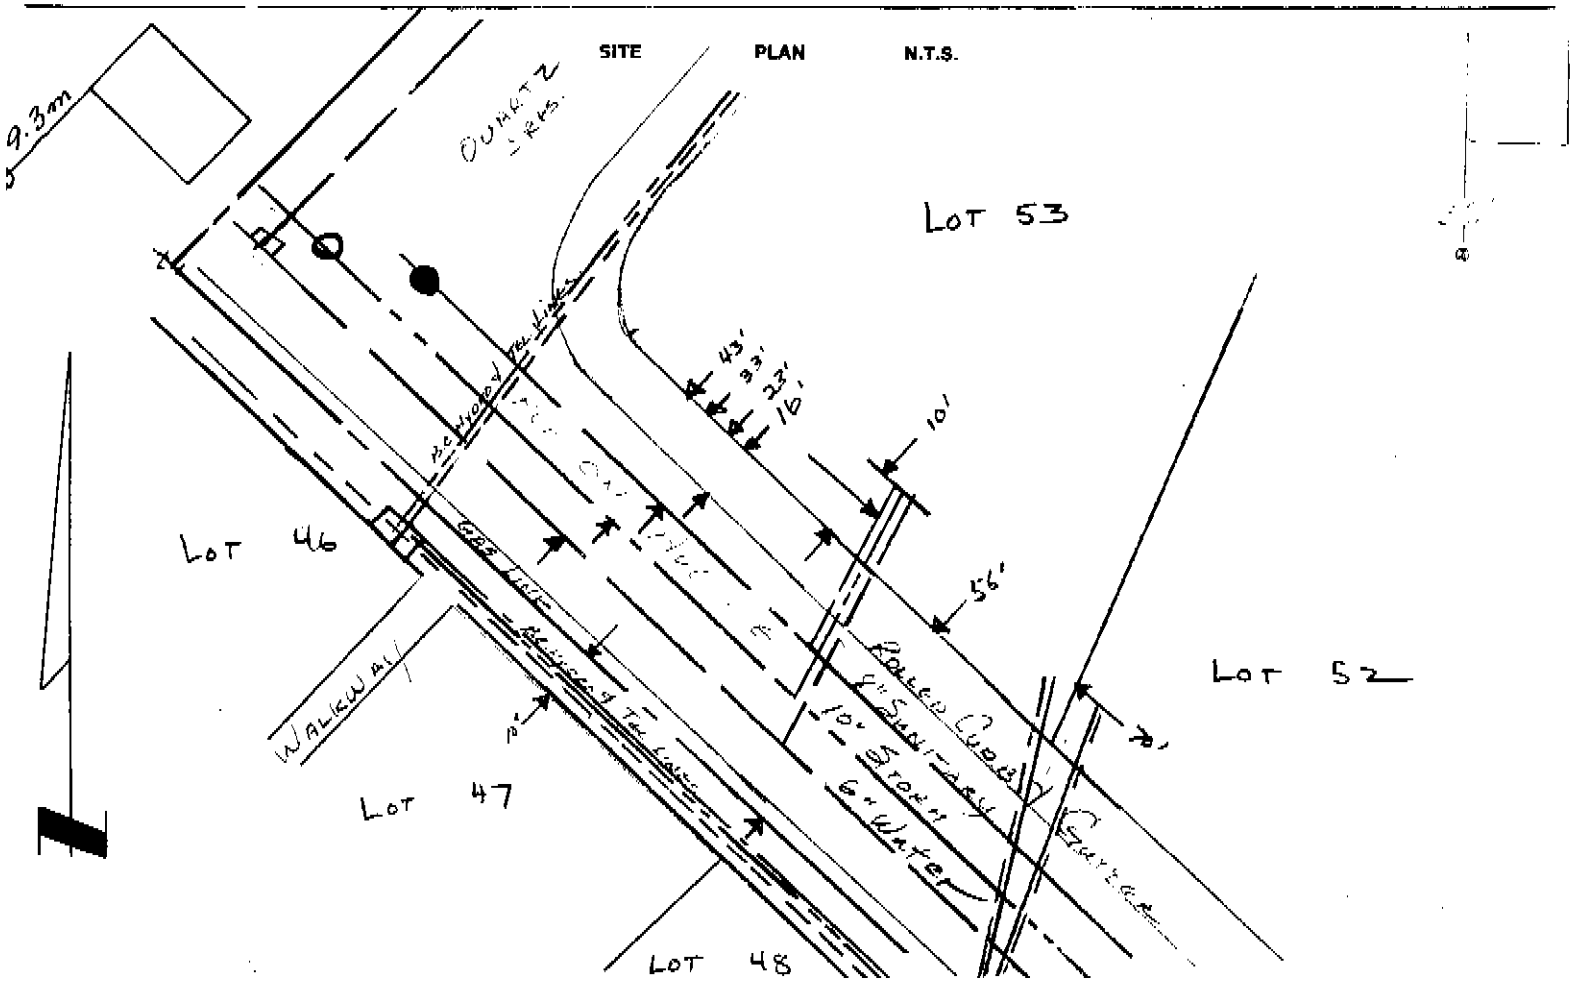
SITE PLAN N.T.S.